


# WATER RIGHTS PERMIT APPLICATION MAP

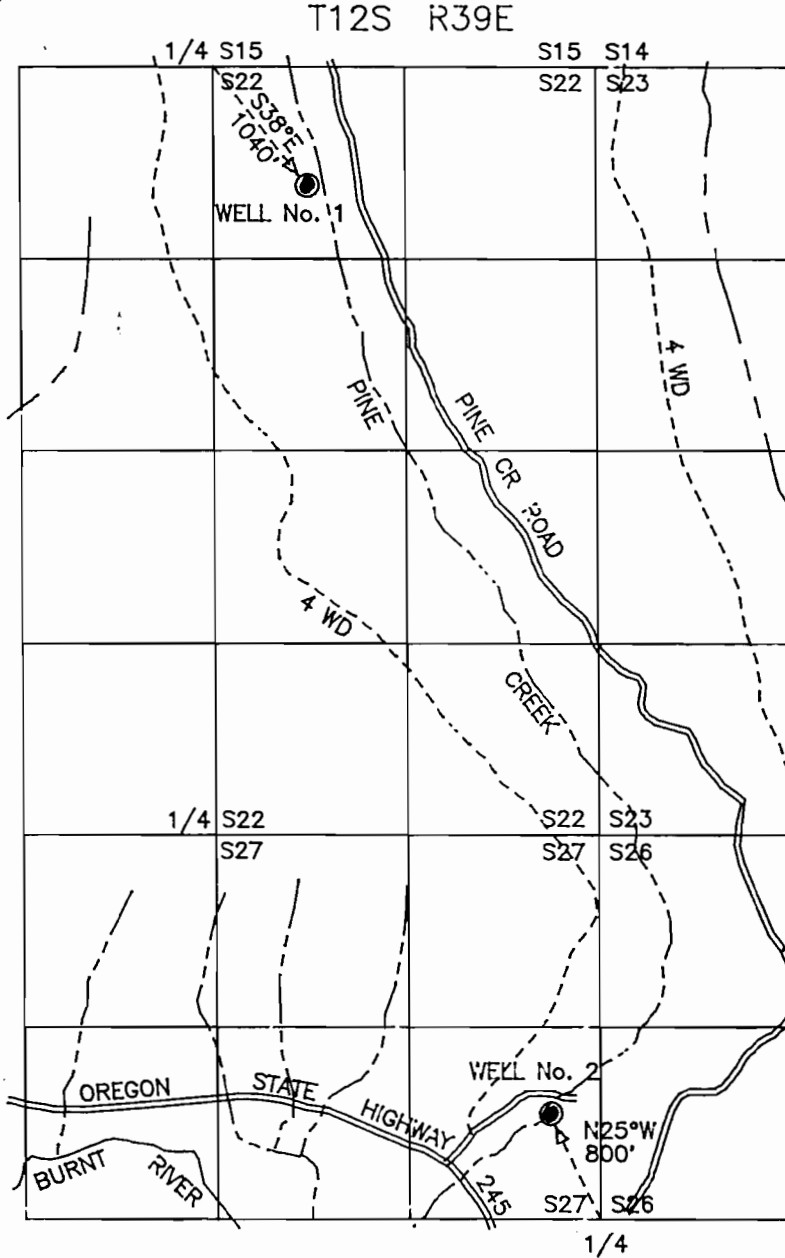

Applicant: Kenneth D. Casper  
812 7th St. S  
Nampa, ID 83651

Scale 1" = 1320'




PERMIT # G-13512

Today's Date of this letter Dec 11-95

These 2 wells have been ready for inspection and proving up or for over a year as I have stated in past letters for Casper

Places of use are various placer gold deposits in Sections 9, 10, 14, 15, 16, 22 & 23, T12S, R39E, WM.

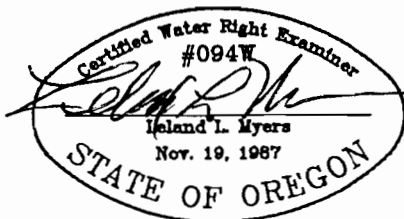

This map is for the purpose of identifying the location of the water right only and has no intent to provide dimensions or location of property ownership lines.