


# FINAL PROOF SURVEY


UNDER

APPL. NO. G-13687 PERMIT NO. G-12528  
 IN THE NAME OF DALE N. & SUSAN F. LESTER

SCALE 1" = 400'

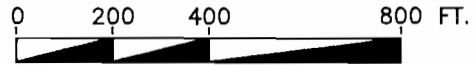

## LEGEND

- FOUND ALUMINUM CAP MONUMENT.
- SECTION LINE.
- - - 1/4, 1/4 SECTION LINE.
- ⊙ POINT OF DIVERSION - WELL LOCATED 1178 FT. NORTH AND 88 FT. EAST OF THE SW CORNER SECTION 31.
- - - - - EXISTING 4" BURIED IRRIGATION MAINLINE.
-  IRRIGATION AREAS PROOFED THIS SURVEY UNDER PERMIT NO. G-12528.

1/4 COR.  
AL. CAP


R10E  
R11E

PLAINVIEW ROAD

NW1/4, SW1/4	NE1/4, SW1/4
SW1/4, SW1/4	SE1/4, SW1/4

POND

34.1 AC.

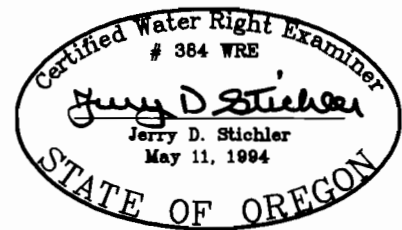

RENEWAL 6/30/02

## NOTES

1. PREPARATION OF THIS MAP IS FOR PURPOSES OF IDENTIFYING PROPOSED WATER RIGHTS ONLY. IT HAS NO INTENT TO PROVIDE LOCATIONS OR DIMENSIONS OF PROPERTY BOUNDARIES.

36  
31

SEC. COR.  
AL. CAP

T15S

T16S

1 | 6

DATE: 07/10/00 ACAD: 0019WR

FINAL PROOF SURVEY  
 APPLICATION NO. G-13687 PERMIT NO. G-12528  
 LOCATED IN THE SW1/4 OF THE SW1/4 OF SECTION 31,  
 T15S, R11E, W.M., DESCHUTES COUNTY, OREGON

ANDERSON ENGINEERING & SURVEYING  
 1618 SW HIGHLAND AVE., P.O. BOX 419  
 REDMOND, OREGON 97756  
 (541) 923-4307  
 (541) 923-4308 FAX

