


T 21 S, R 20 E, WM

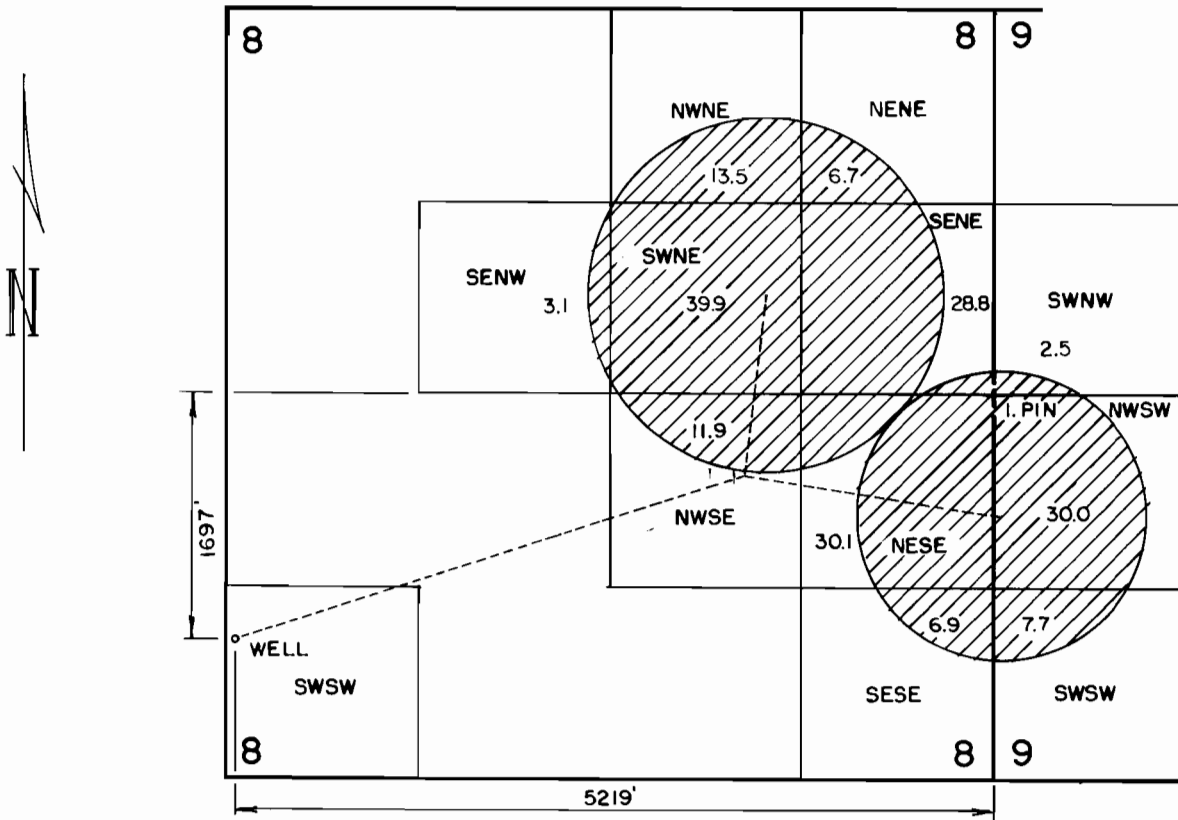

THE PURPOSE OF THIS MAP IS TO IDENTIFY THE LOCATION OF THE WATER RIGHT. IT IS NOT INTENDED TO PROVIDE INFORMATION RELATIVE TO THE LOCATION OF PROPERTY OWNERSHIP.

RECEIVED

<p>RENEW 01-01-2001</p>	FINAL PROOF SURVEY		IN THE NAME OF ROBERT L. & JOYCE E. COATS
	UNDER APPLICATION NO. G-13642 PERMIT NO. G-12551		
	Scale: 4" = 1 MILE	Date: SEPT. 2000	Job: 1422-00
	Dsn:	M. A. PALMER & SONS, INC. ENGINEERING & SURVEYING 254 N. Alder - Box 61 Burns, Oregon 97720	Sht. No.
Drn: CHRIS	of 1		
Ckd:			