




Township 5 South, Range 2 West, W.M.

Section 24


Tax Lot No. 1800/44363000

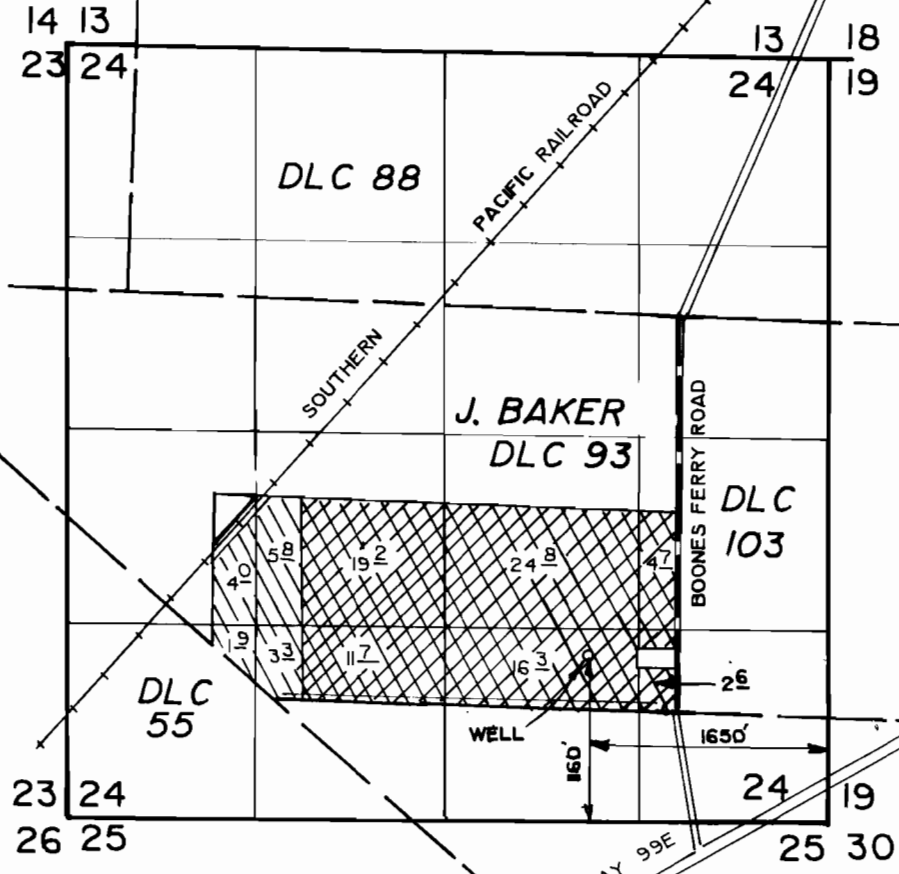

-  EXISTING WATER RIGHTS UNDER CERTIFICATE NO GR 3533
-  NEW APPLICATION

Appl. No. G-13915
 Permit No. G-12555

FINAL PROOF SURVEY
 for
 GESCHWILL FARMS

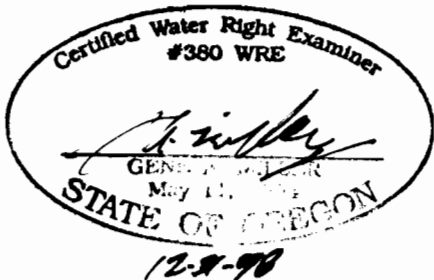

THIS MAP WAS PREPARED FOR THE PURPOSE OF IDENTIFYING THE LOCATION OF A WATER RIGHT ONLY AND IS NOT INTENDED TO PROVIDE LEGAL DIMENSIONS OR LOCATION OF PROPERTY OWNERSHIP RIGHTS.