




Township 5 South, Range 1 And 2 West, W.M.

Portions of Sections 24 and 19

Tax Lot No. 1700/44365001

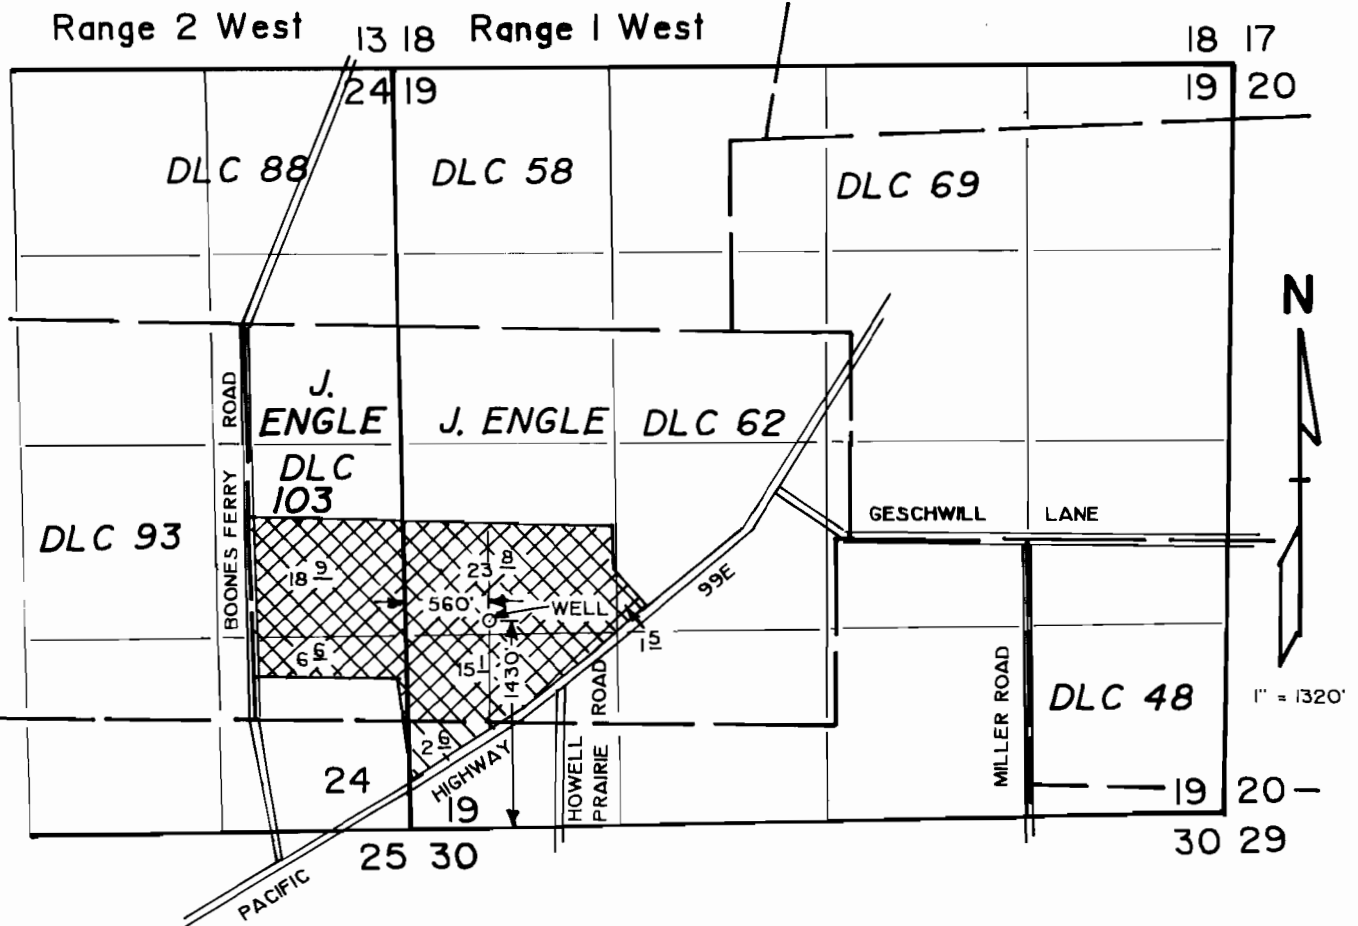


-  EXISTING WATER RIGHTS UNDER CERTIFICATE NO. GR 1340
-  NEW APPLICATION

Appl. No. G-13918

Per. No. G-12556

FINAL PROOF SURVEY for GESCHWILL FARMS

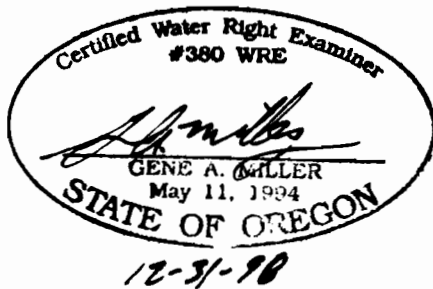

THIS MAP WAS PREPARED FOR THE PURPOSE OF IDENTIFYING THE LOCATION OF A WATER RIGHT ONLY AND IS NOT INTENDED TO PROVIDE LEGAL DIMENSIONS OR LOCATION OF PROPERTY OWNERSHIP RIGHTS.