


Township 6 South, Range 1 West, W.M.

Portions of Sections 23, 24, 25 & 26

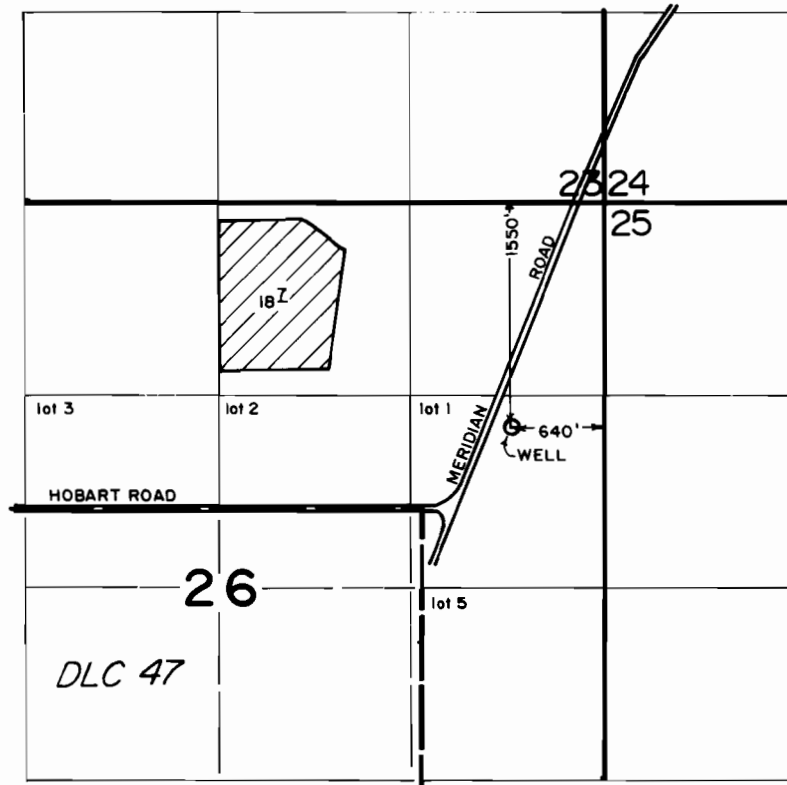


FINAL PROOF SURVEY
under

Appl. No. G-12984, Per. No. G-12564
in name of

GOSCHIE FARMS, INC.

Sep. 2, 1999

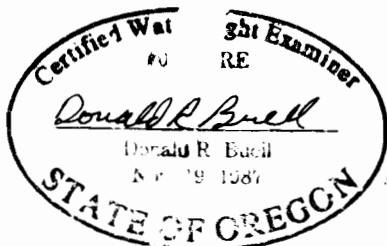

THIS MAP WAS PREPARED FOR THE PURPOSE OF IDENTIFYING THE LOCATION OF A WATER RIGHT ONLY AND IS NOT INTENDED TO PROVIDE LEGAL DIMENSIONS OR LOCATION OF PROPERTY OWNERSHIP LINES.