



TOWNSHIP 15 SOUTH, RANGE 4 WEST, W.M.

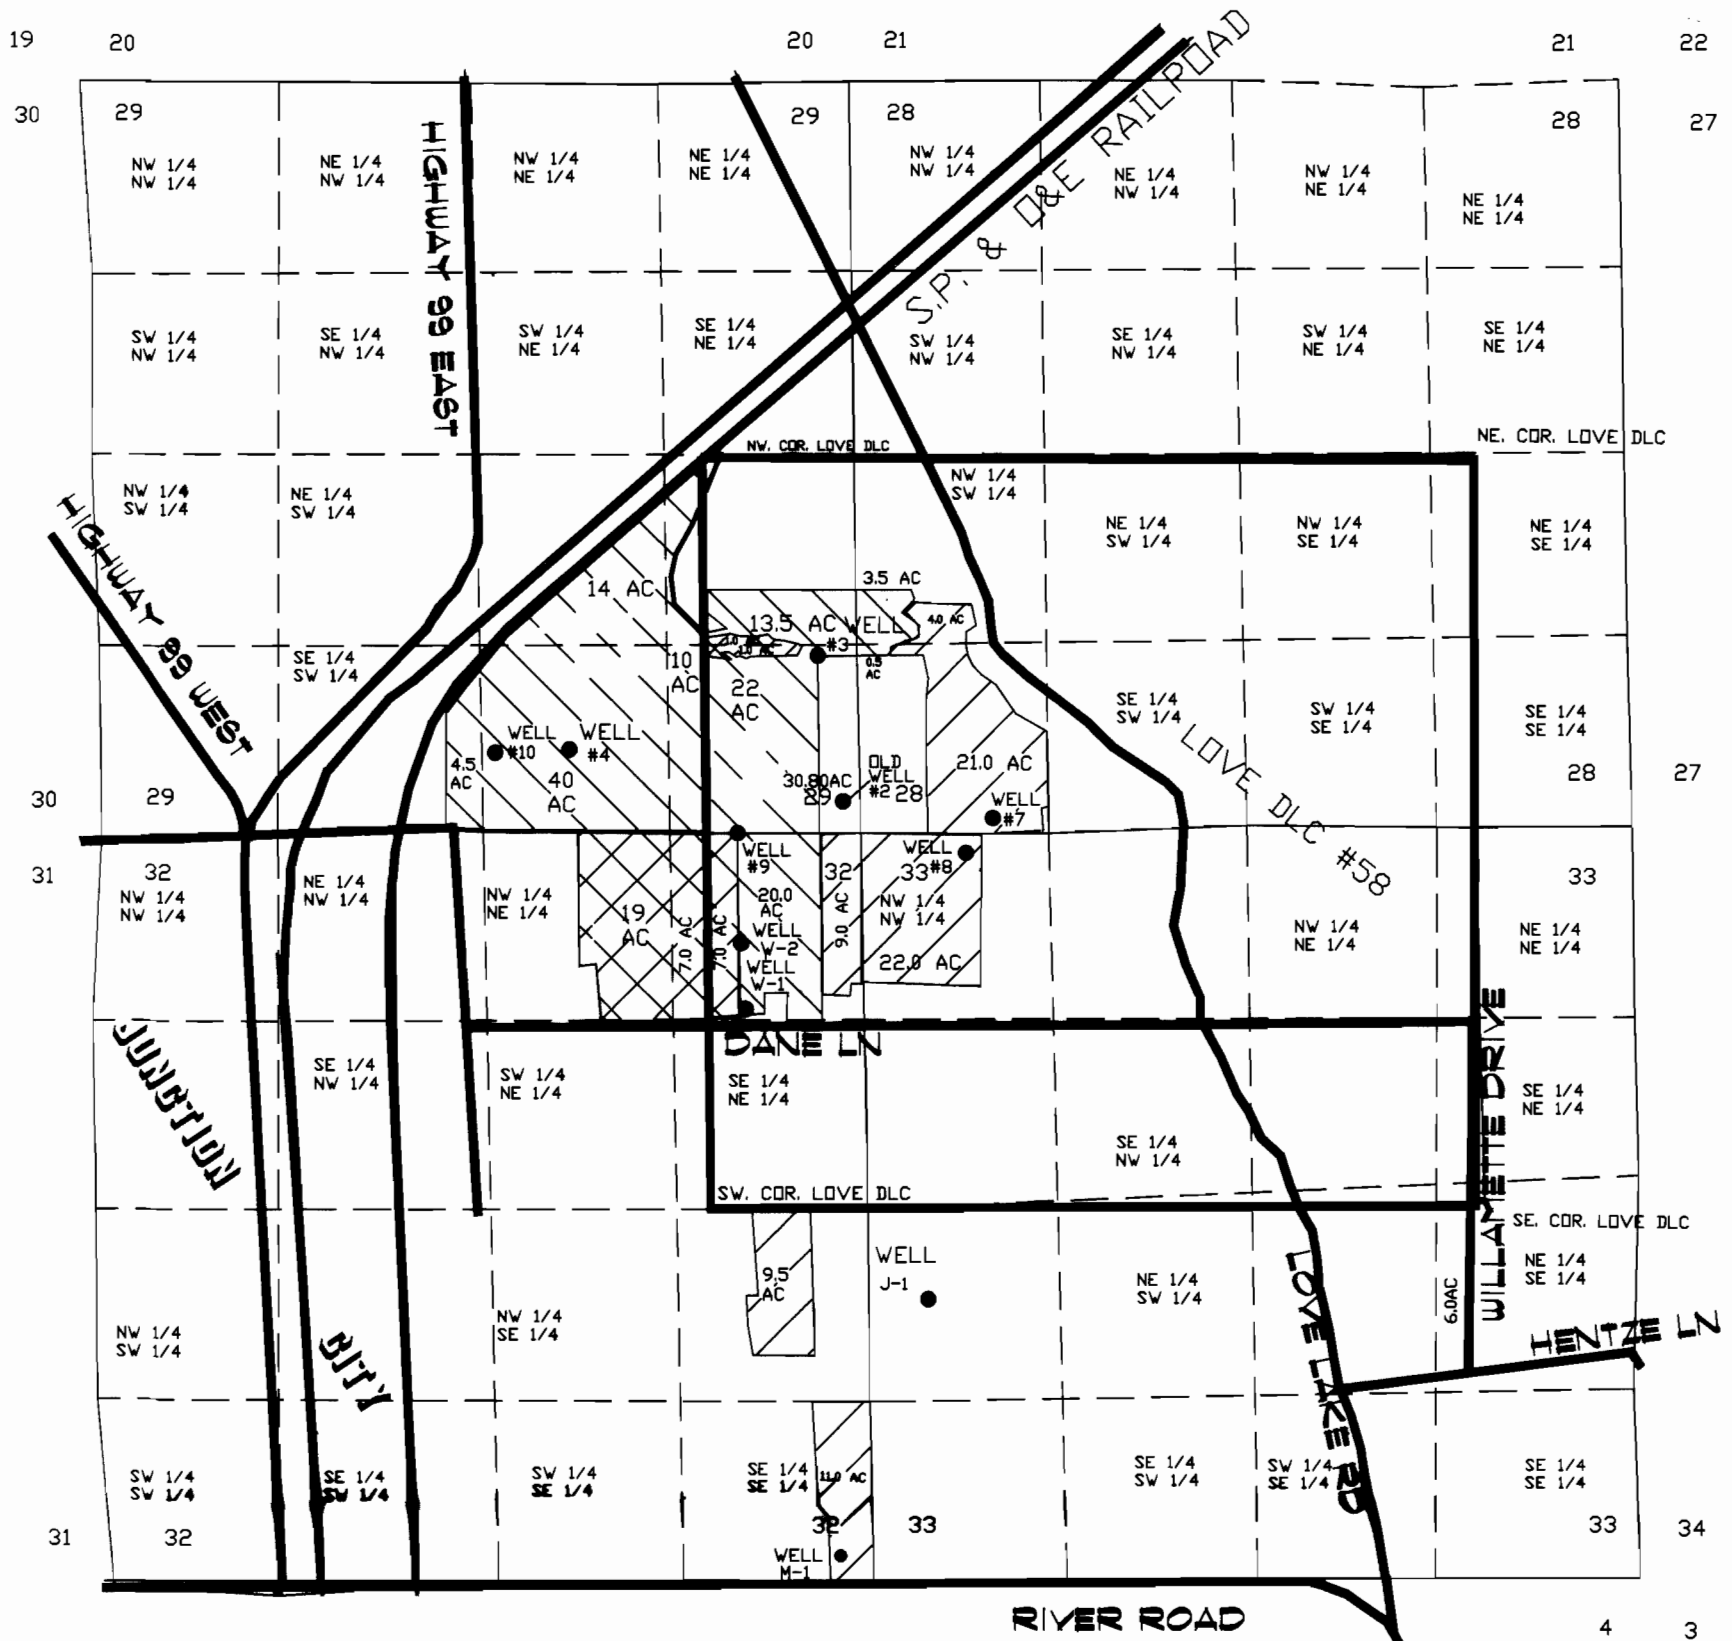

APPLICATION G-13283 PERMIT G-12568

FINAL PROOF SURVEY  
FOR  
REERSLEY FARM  
220 E. 18TH AVE  
JUNCTION CITY, OR 97448  
(PH) 541-998-1550

BY  
FORD-NESS-FASSBENDER, INC.  
PO BOX 22735  
EUGENE, OR 97402  
(PH) 541-344-1852  
APRIL 6, 1999

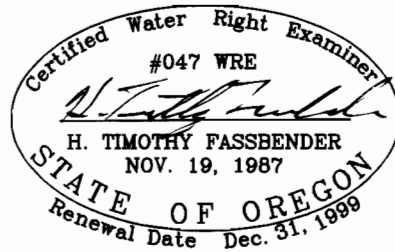


SCALE  
1" = 1320'

NOTE:

THE PREPARATION OF THE MAP WAS FOR THE PURPOSE OF IDENTIFYING THE LOCATION OF THE WATER RIGHT ONLY. IT IS NOT INTENDED TO PROVIDE LOCATION NOR DIMENSION OF PROPERTY OWNERSHIP LINES.



PRIMARY RIGHT

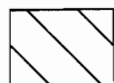

SUPPLEMENTAL RIGHT

WELL LOCATION:

- OLD WELL #2 N87°E 5160 FEET FROM SW COR. SEC. 29
- WELL #3 1219' N & 297' W. OF S.E. COR. SEC 29
- WELL #4 590' N. & 2000' W. OF S.E. COR. SEC. 29
- WELL #7 95' N. & 920' E. OF S.E. COR. SEC. 29
- WELL #8 160'S. & 725' E. OF S.E. COR. SEC. 29
- WELL #9 5' N. & 847' W. OF S.E. COR. SEC. 29
- WELL #10 545' N. & 2513' W. OF S.E. COR. SEC. 29
- WELL M-1 191' N & 230 W. OF S.E. COR. SEC. 32
- WELL W-1 1320' S. & 800' W. OF N.E. COR. SEC. 32
- WELL W-2 755' S & 826' S. OF N.E. COR. SEC. 32
- WELL J-1 1970' N. & 369' E. OF S.E. COR. SEC. 33