


Township 5 South, Range 1 and 2 West, W.M.

Portions of Sections 24, 25, 19 and 30


Tax Lot No. 100/44404000

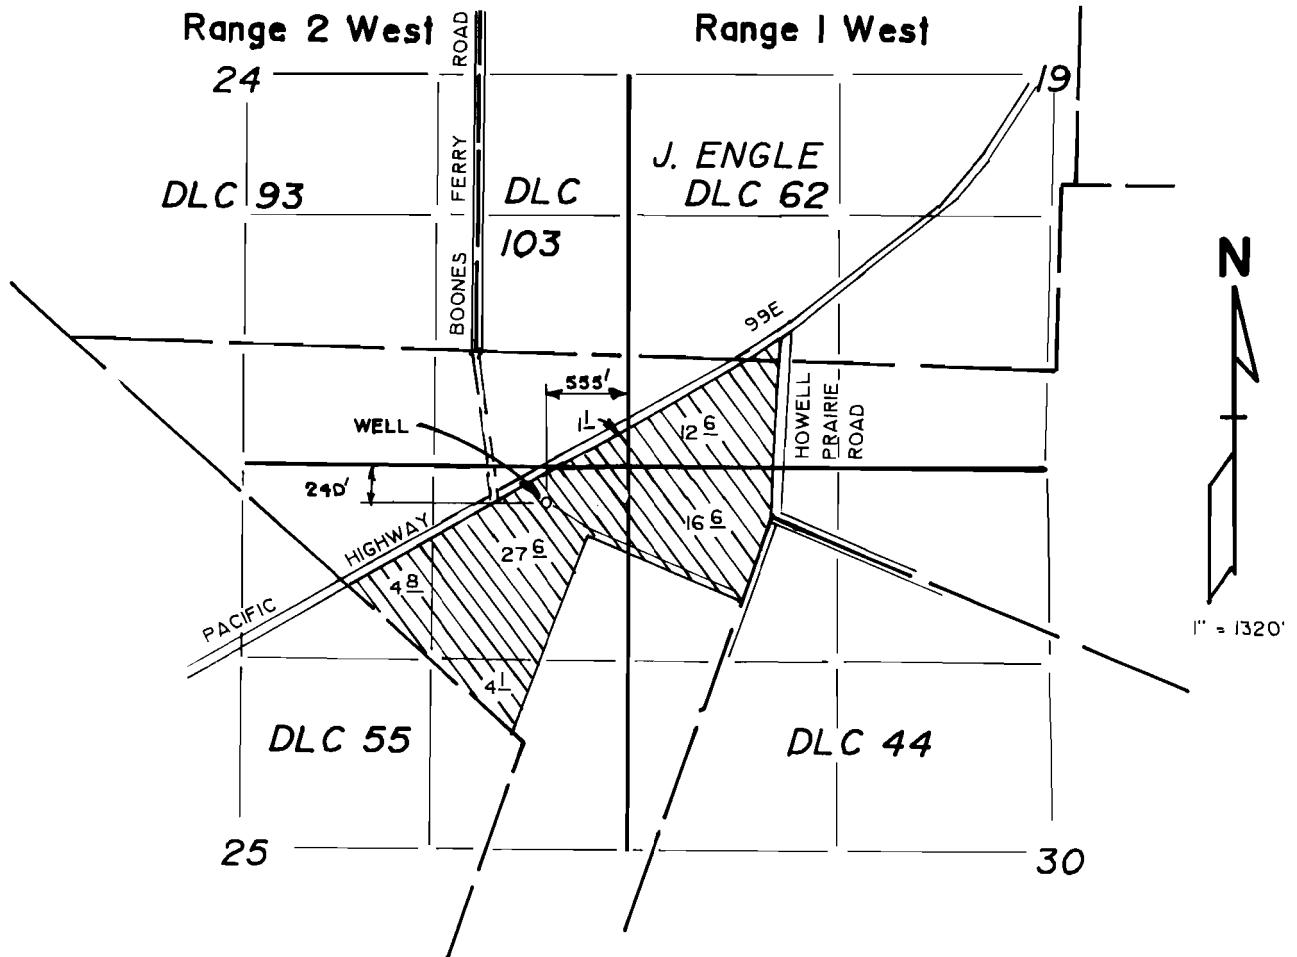

Appl. No. G-13917

Permit No. G-12573

FINAL PROOF SURVEY
for
GESCHWILL FARMS

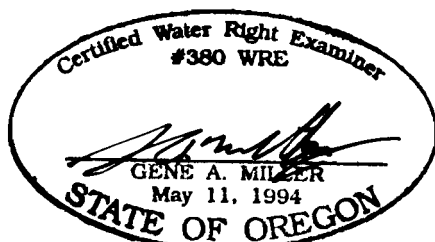

12-21-98

THIS MAP WAS PREPARED FOR THE PURPOSE OF IDENTIFYING THE LOCATION OF A WATER RIGHT ONLY AND IS NOT INTENDED TO PROVIDE LEGAL DIMENSIONS OR LOCATION OF PROPERTY OWNERSHIP RIGHTS.