

**TABLE OF IRRIGATION AREAS**  
IN T.3 S., R.40 E., W.M., UNION COUNTY

**SECTION 6**

SW 1/4 OF SE 1/4	21 AC.	
SE 1/4 OF SE 1/4	16 AC.	<u>37 ACRES</u>
		TOTAL

**SECTION 7**

NW 1/4 OF NE 1/4	28 AC.	
NE 1/4 OF NE 1/4	21 AC.	
SW 1/4 OF NE 1/4	37 AC.	
SE 1/4 OF NE 1/4	33 AC.	
NW 1/4 OF SE 1/4	37 AC.	
NE 1/4 OF SE 1/4	33 AC.	
SW 1/4 OF SE 1/4	33 AC.	
SE 1/4 OF SE 1/4	33 AC.	
NE 1/4 OF SW 1/4	5 AC.	
SE 1/4 OF NW 1/4	5 AC.	
		<u>265 ACRES</u>
		TOTAL

**SECTION 18**

NW 1/4 OF NE 1/4	33 AC.	
NE 1/4 OF NE 1/4	33 AC.	
		<u>66 ACRES</u>
		TOTAL

TOTAL AREA TO BE IRRIGATED = 368 ACRES

**RECEIVED**

AUG 17 1995


WATER RESOURCES DEPT.  
SALEM, OREGON

permit # G12578

**NOTE:**

THE TOTAL AREA TO BE IRRIGATED IS BASED ON THE EFFECTIVE RADIUS OF IRRIGATION OF THE CENTER PIVOT IRRIGATION SYSTEMS. THE IRRIGATED AREA IN EACH 1/4-1/4 SECTION HAS BEEN ESTIMATED.

REVISOR'S MARK: REVISED AUG. 7, 1995 TO SHOW TWO - 5 ACRE AREAS IN SEC. 7.

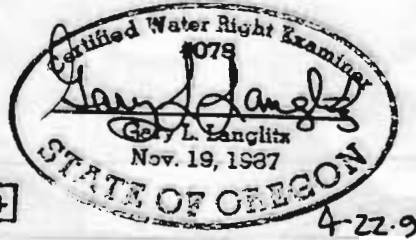

EXPIRES: 12-31-94



**APPLICATION MAP**

FOR: CONLEY FARMS  
61050 CONLEY ROAD  
COVE, OREGON 97824

**FIGURE**

**1**

155601