

# FINAL PROOF MAP

LOCATED IN THE S.E 1/4 OF SECTION 18  
TOWNSHIP 3 SOUTH, RANGE 4 EAST, WILLAMETTE MERIDIAN  
CLACKAMAS COUNTY, OREGON

SCALE: 1" = 400'

SEPTEMBER 7, 1999

APPLICATION NO. G-13931 PERMIT NO. G-12586


CLIENT: ESTACADA ROCK PRODUCTS

NOTE: THIS DRAWING IS AN APPLICATION TO APPROPRIATE GROUNDWATER, IT IS NOT A LAND SURVEY. PROPERTY LINES AND/OR OTHER LINES OF OCCUPATION SHOWN HEREON ARE NOT REPRESENTED BY THE UNDERSIGNED TO MEET ACCURACY STANDARDS OF LAND SURVEYS.



**all** COUNTY SURVEYORS & PLANNERS, INC.  
P.O. BOX 955  
SANDY, OREGON 97055  
(503) 668-3151

JOB NO. 94-313A

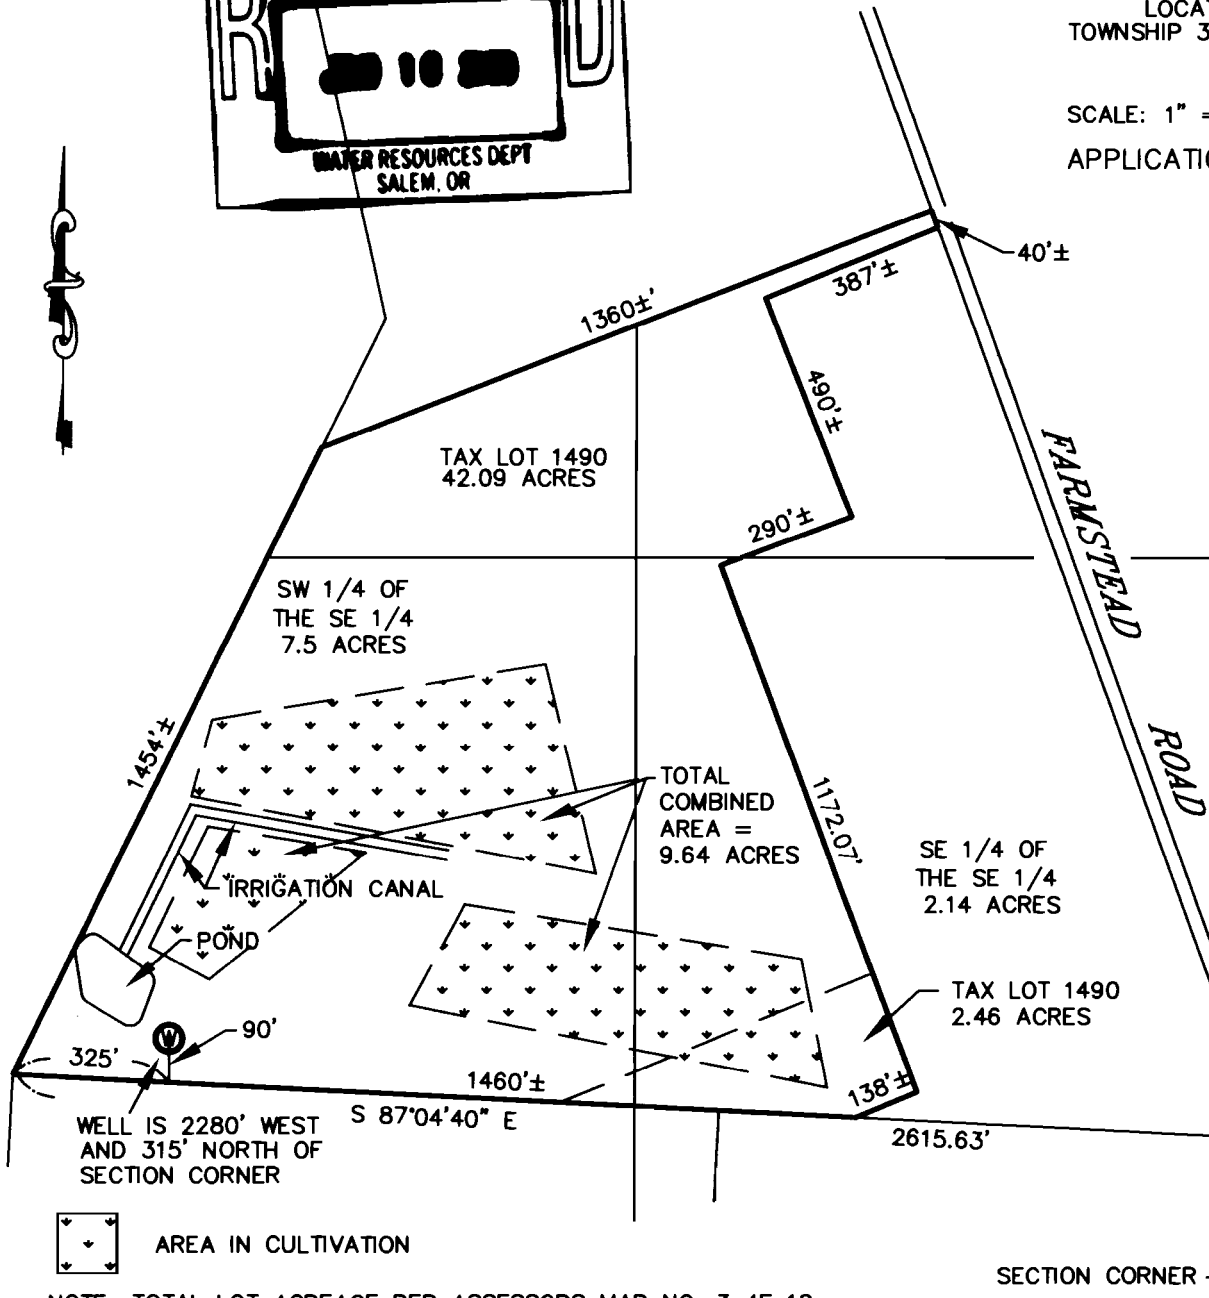

AREA IN CULTIVATION

NOTE: TOTAL LOT ACREAGE PER ASSESSORS MAP NO. 3 4E 18