

RECEIVED


JAN 15 1999

WATER RESOURCES DEPT.
SALEM, OREGON

T6N, R35E, WM



SCALE = 1" : 500'

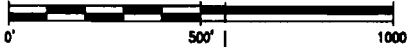

Well 1



Tax Lot 801

Tax Lot 500

Tax Lot 506

WINE GRAPES
IRRIGATION
24.0 ACRES

10.9 ACRES

13.1 ACRES

N 0, 20', 59" E

N 41, 23', 56" W

DIVERSION POINT(S):

WELL 1:

Located 70 feet West and 30 feet South from the NE corner,
of the NE 1/4, of the SE 1/4, Section 32, T6N, R35E, WM.

32 33
5 4

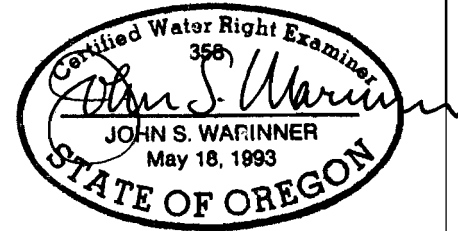


Exhibit B

FINAL PROOF SURVEY

Application #G-13759

Permit #G-12598

In The Name Of:

McKibben Family Limited Partnership

Surveyed, Jan. 7, 1999, by John Warinner

Project Name:

MFLP
Walla Walla, WA
Project No. 98-21
Date:
01-08-99



**Fountainhead
Irrigation, Inc.**

PO Box 2197 Walla Walla, WA 99362
Phone (509) 529-2646 Fax (509) 522-5251