


T. 16 S. R. 4 W. W. M.

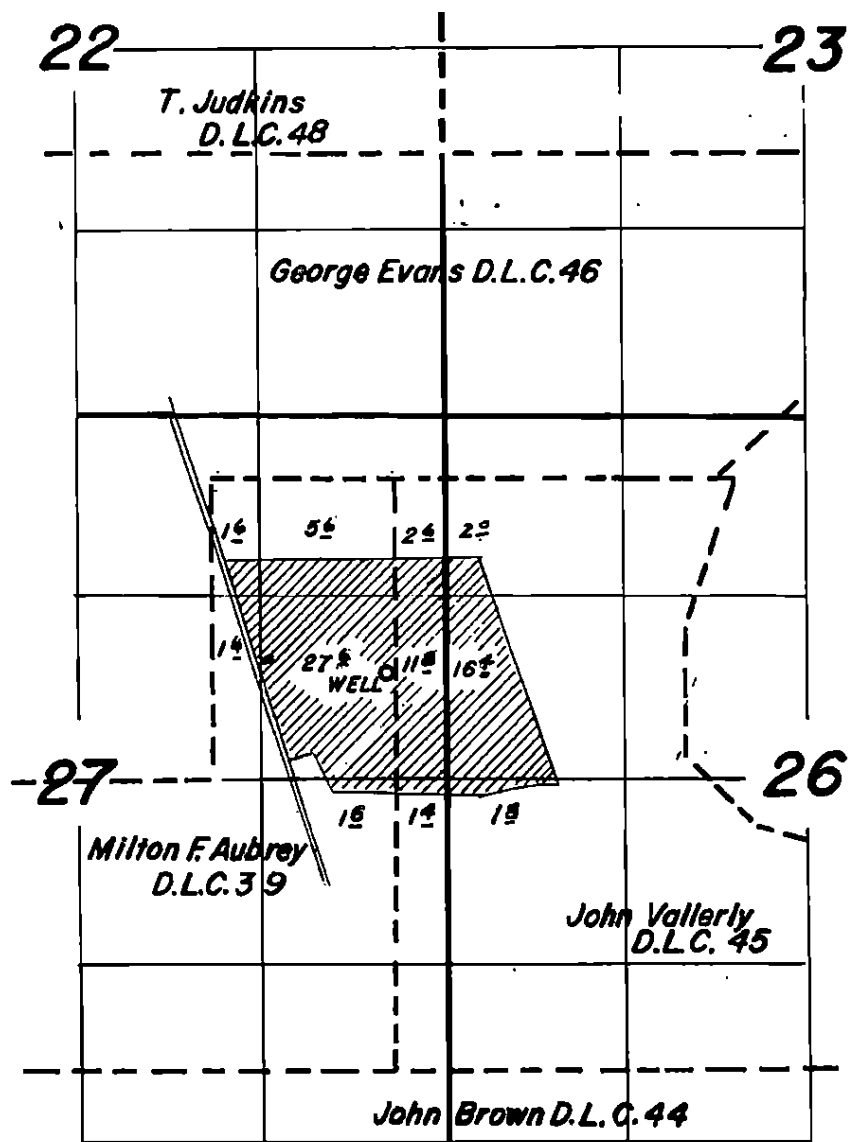

FINAL PROOF SURVEY  
UNDER

Application No. G-1398 Permit No. G-1260  
IN NAME OF

Herbert L. Hostick

Surveyed June 18, 1963, by T. Lauer