


# FINAL PROOF SURVEY MAP IN THE NAME OF RAYMOND GARDNER

APPLICATION G-13158

PERMIT G-12604


SECTION 29, TOWNSHIP 28 SOUTH, RANGE 14 WEST, W.M.

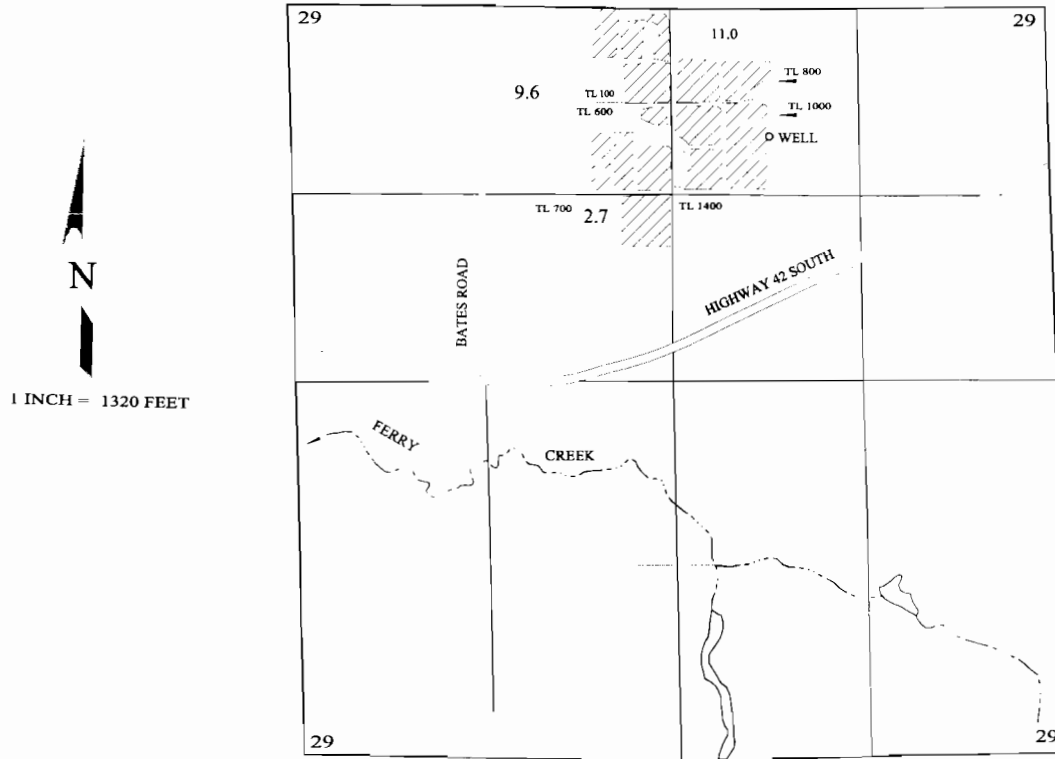

THE WELL IS LOCATED 900 FEET SOUTH AND 1880 FEET WEST FROM THE NORTHEAST CORNER OF SECTION 29, BEING WITHIN THE NW $\frac{1}{4}$ NE $\frac{1}{4}$  OF SECTION 29, TOWNSHIP 28 SOUTH, RANGE 14 WEST, W.M.; COOS COUNTY.

RECEIVED

WATER RIGHT  
SALE

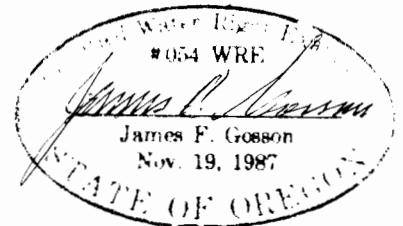

THE PURPOSE OF THIS MAP IS TO IDENTIFY THE LOCATION OF THE WATER RIGHT. IT IS NOT INTENDED TO PROVIDE INFORMATION RELATIVE TO THE LOCATION OF PROPERTY OWNERSHIP BOUNDARY LINES.