


FINAL PROOF SURVEY  
 in the name of: BEN FOX  
 SECTION 14, T.2S., R.3E., W.M.  
 SCALE 1/4" = 400 FEET

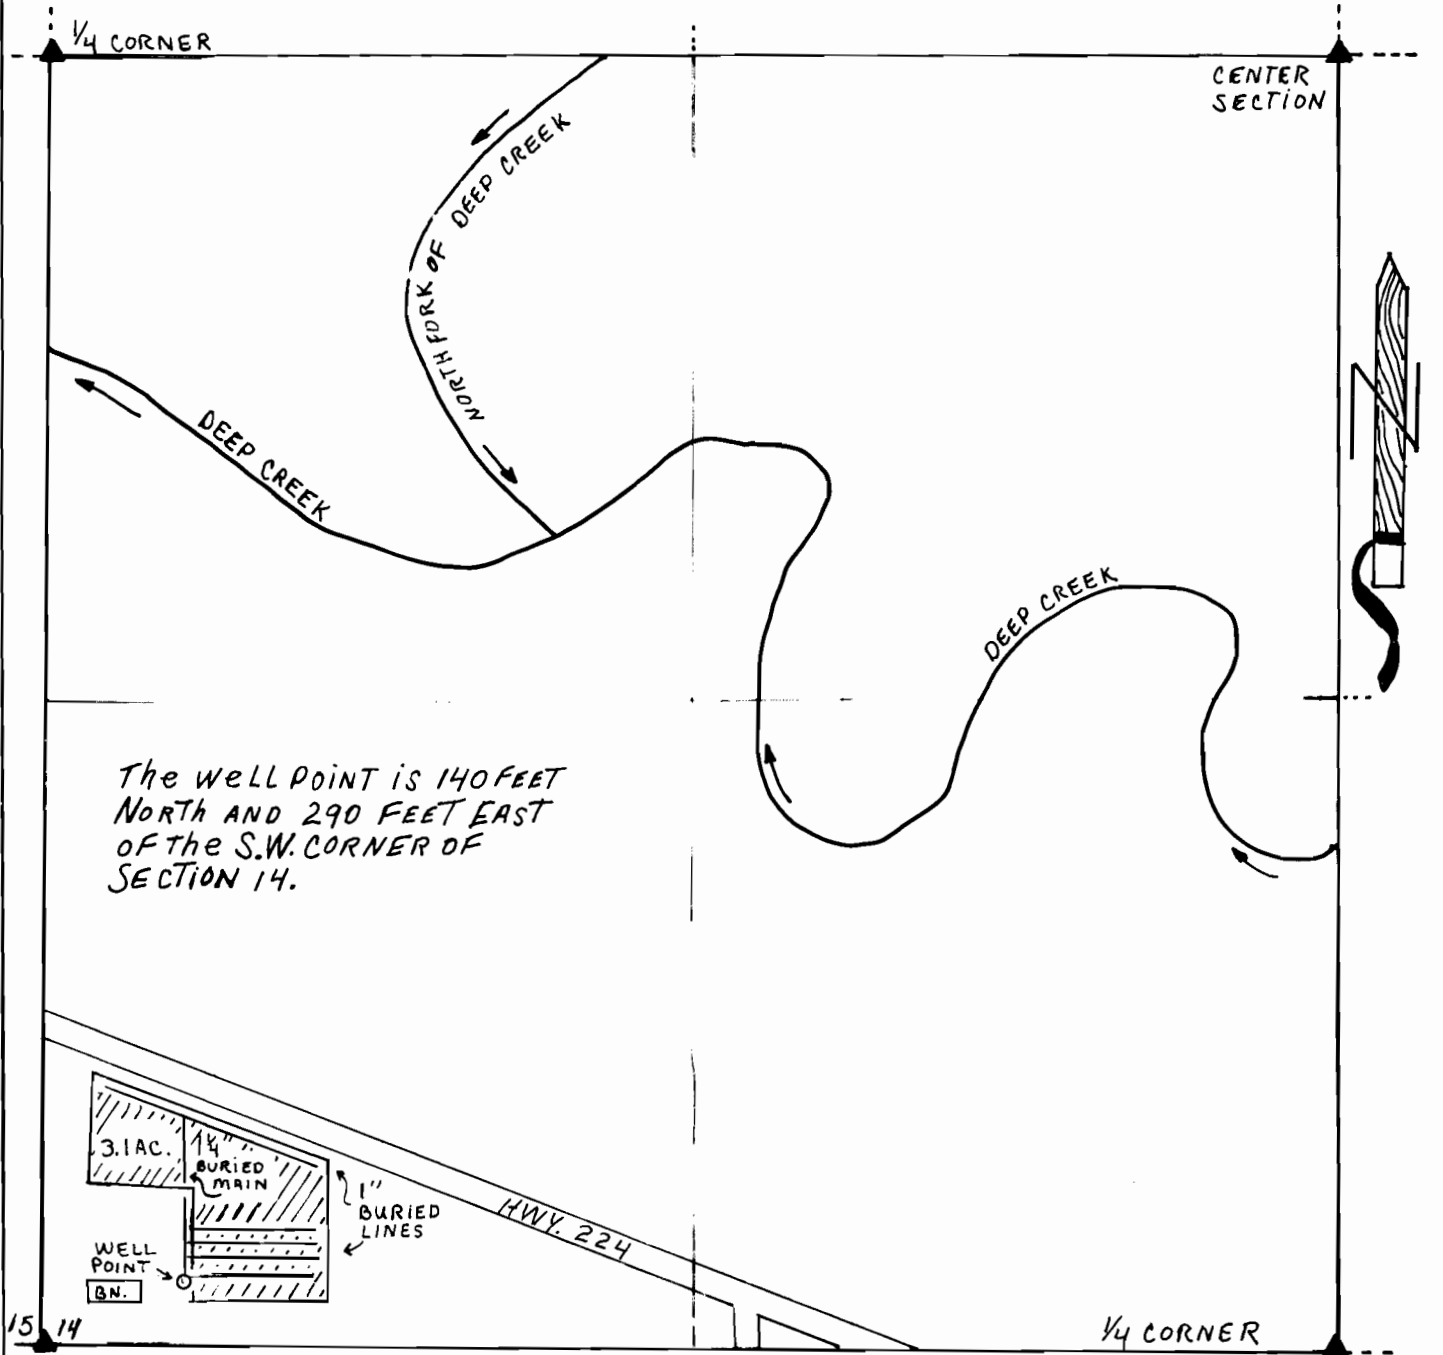

The well point is 140 FEET  
 North and 290 FEET EAST  
 of the S.W. CORNER OF  
 SECTION 14.

15 14  
 22 23

BASIS OF BEARING PS. 17165

APPLICATION # G 14063  
 PERMIT # G 12621  
 SURVEYED MARCH 11, 2003

*Arthur J. Ellis*