

T.1S. R.3W., W.M.


Application No. G-13912

Permit No. G12628

RECEIVED

NOV 22 1994

WATER RESOURCES DEPT
SALEM, OREGON

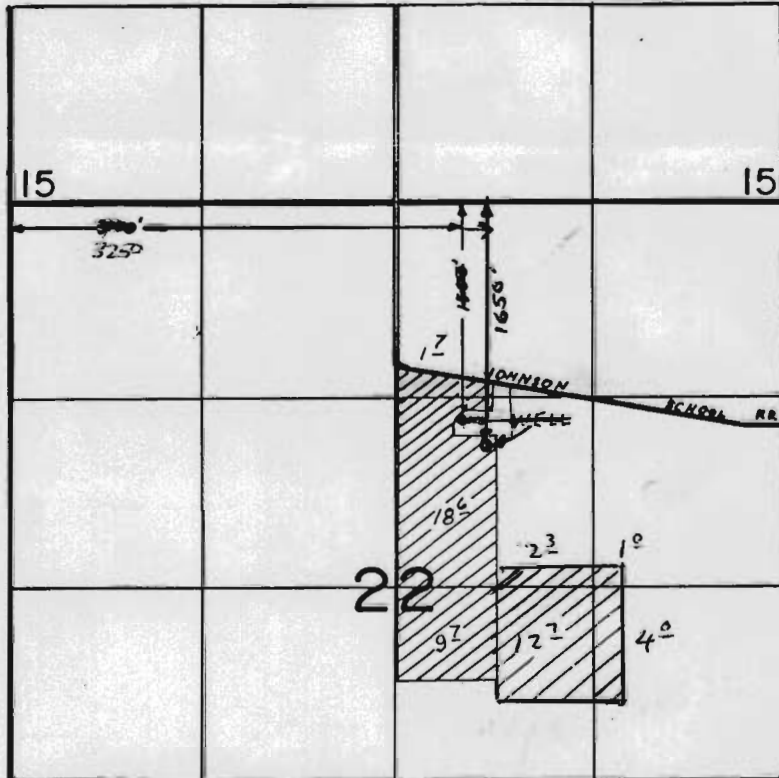

DEC 15 1994

WATER RESOURCES DEPT
SALEM, OREGON

SCALE: 1"=1320'

FINAL PROOF SURVEY
UNDER

Application No. G-6719... Permit No. G-6257...
IN NAME OF

GARY W. DUYCK

Surveyed MAY 4, 1977, by D.M. NORBY
Sept. 25, 1984 B.W. BISHOP

RECEIVED MAY 02 1988

3-7-85

DPR-20-168

001