


Twp 35., Range 3W.

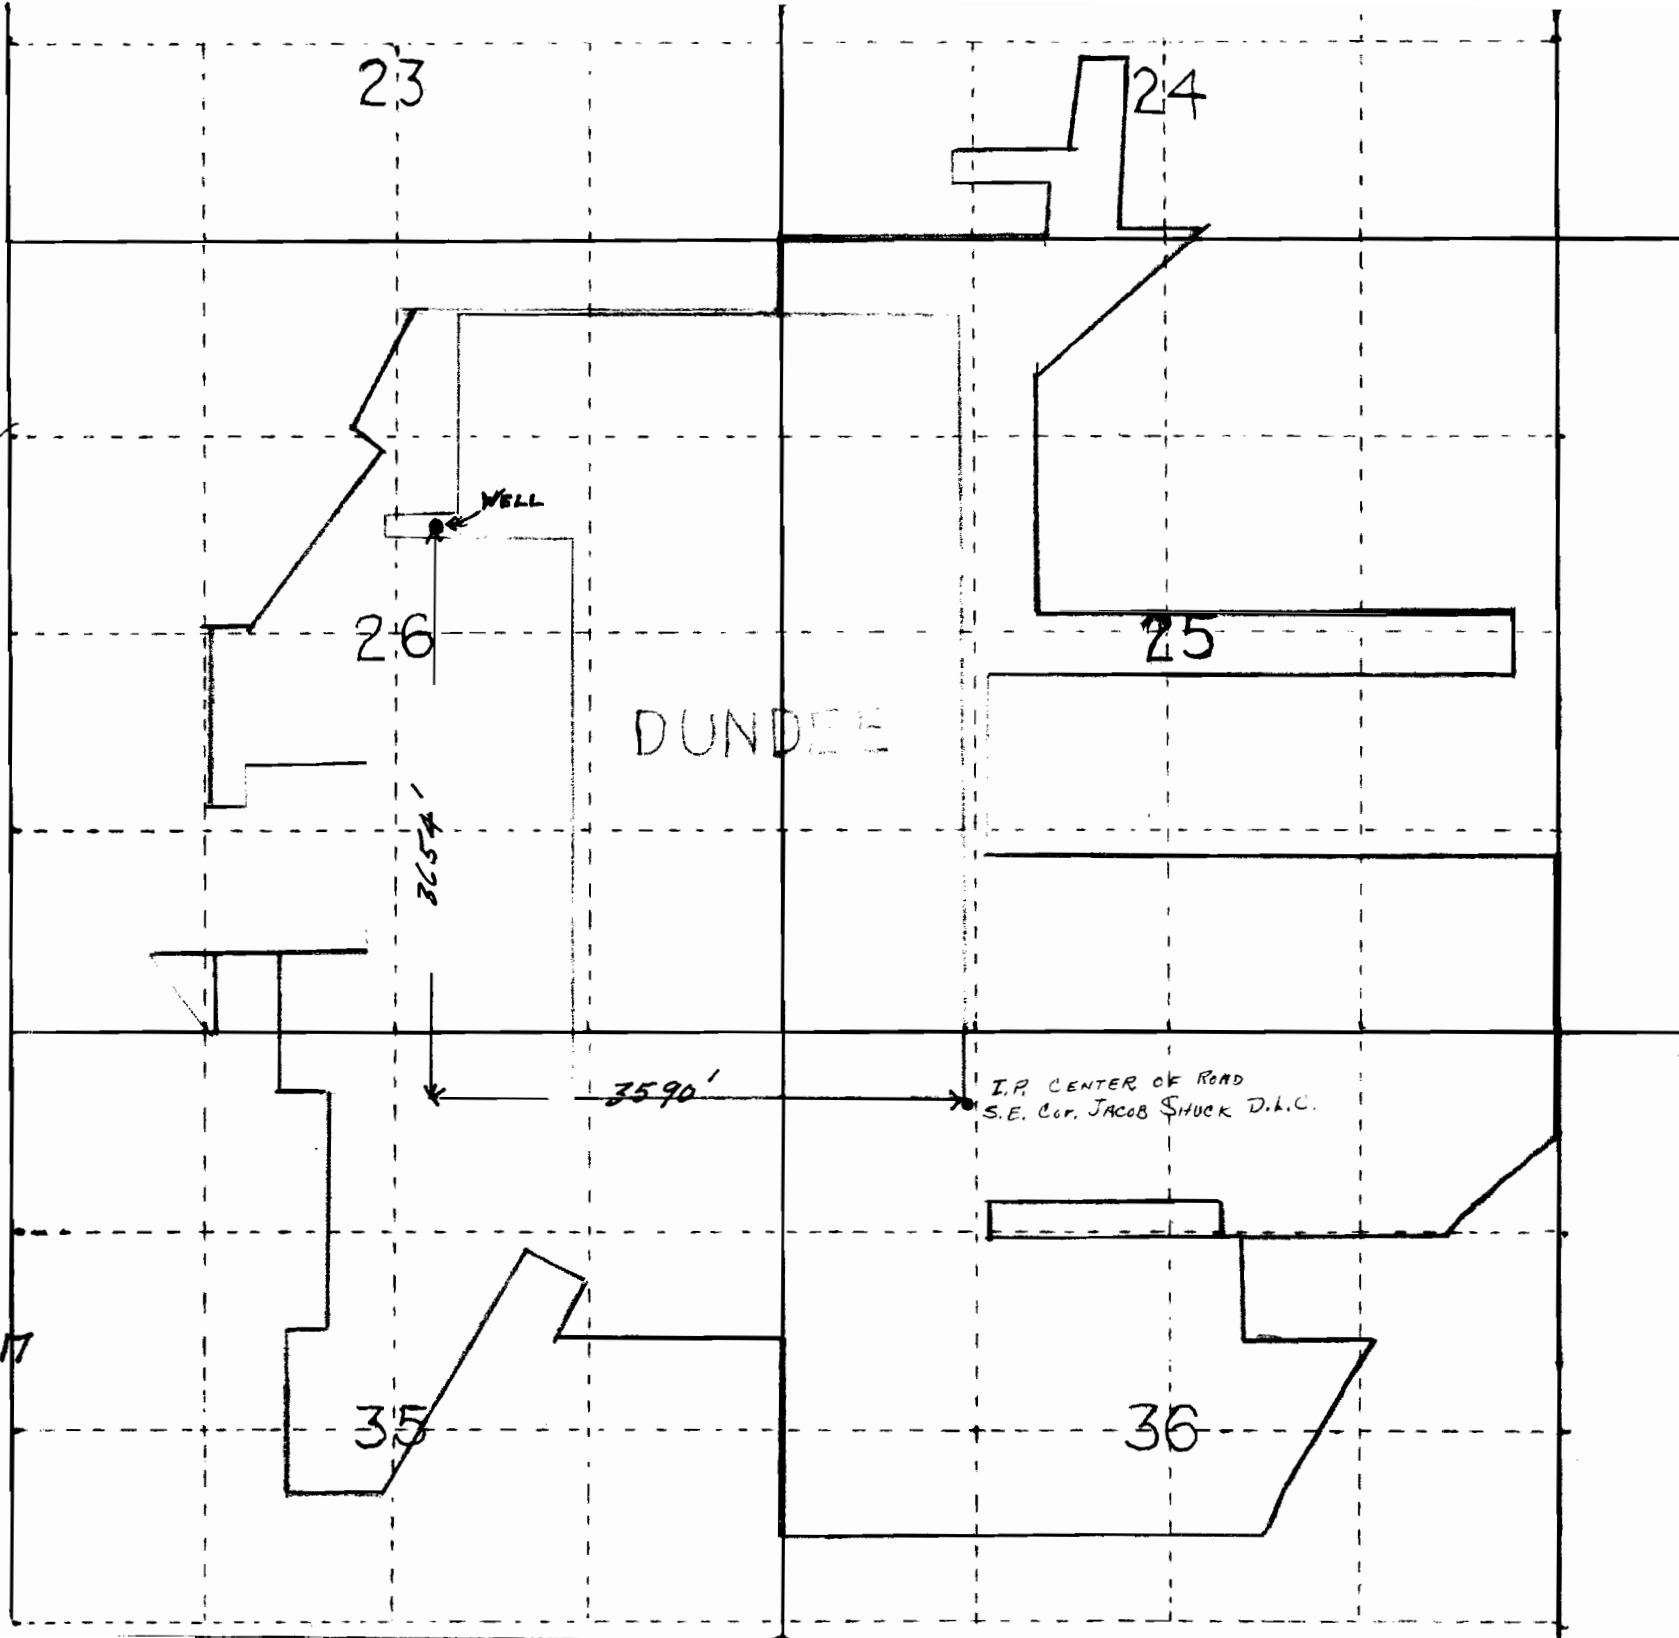

Application No. G-1217
Permit No. G-1263