

CLAIM OF BENEFICIAL USE MAP  
T.38 S. R.05 W. SEC. 27 W.M.


UNDER:  
APPLICATION G-13507  
PERMIT No. G-12635

IN NAME OF:  
RICHARD and JOANN WORTH

WELL IS LOCATED  
985 FEET NORTH &  
720 FEET WEST FROM  
SOUTH 1/4 CORNER  
FOR SECTION 27

CROSS HATCHURE  
SHOWS IRRIGATED  
ACREAGE

DASHED LINE  
SHOWS BURIED  
1" AND 2"  
PVC PIPE

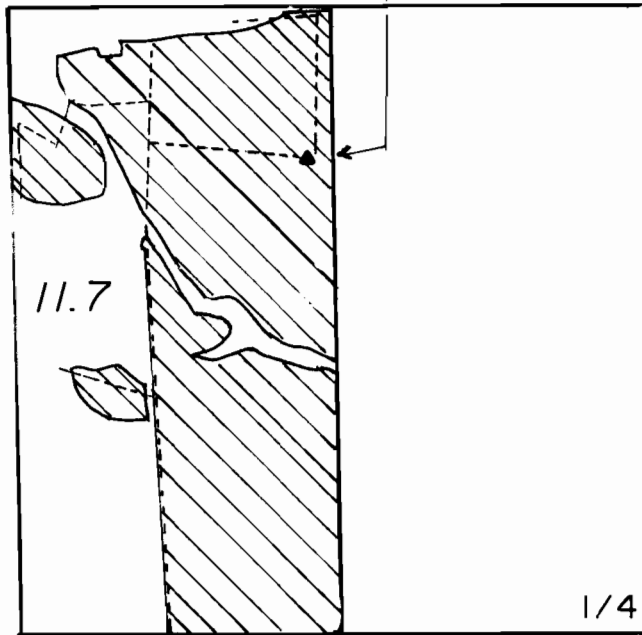


SCALE: 1" = 400'

FOUND IRON PIPE  
W/ BRASS CAP PER  
JOSEPHINE COUNTY  
SURVEYOR'S PROPORTIONED  
CORNER BK. 50 P. 68

SURVEYED SEPTEMBER 24, 2001 BY:

JONATHAN C. SPERO C.W.R.E. 123  
1002 KINCAID RD./P.O. BOX 16  
WILLIAMS, OREGON 97544  
PH. (541) 846-6845

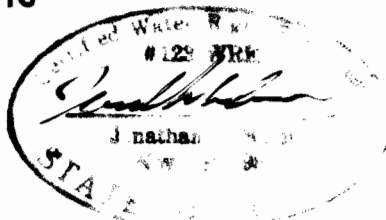

LICENSE RENEWAL DATE:  
JUNE 30, 2002

THIS MAP IS FOR THE PURPOSE OF  
IDENTIFYING THE LOCATION OF THE  
WATER RIGHT ONLY, AND IS NOT IN-  
TENDED TO PROVIDE LEGAL DIMEN-  
SIONS OR LOCATIONS OF PROPERTY  
OWNERSHIP LINES.