


TOWNSHIP 14 SOUTH, RANGE 14 EAST, W. M.
SECTION 8

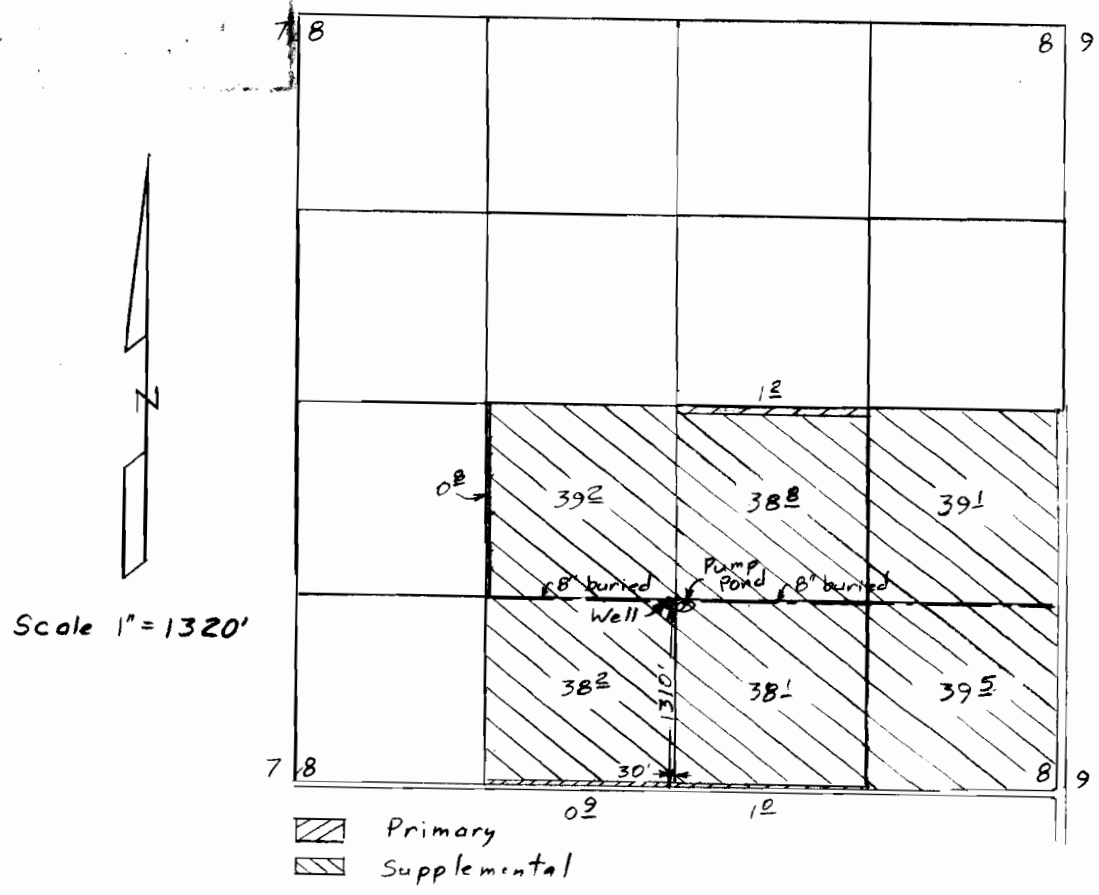

Surveyed Sep. 1, 2000

Claim of Beneficial Use Map
for
DEAN MILLS & MICHAEL MILLS



Application G-12661
Permit G-12642

This map is for the purpose of
locating a water right only
and has no intent to provide
legal dimensions or the location
of property lines.

ESTES SURVEYS
 6253 Sunnyview Rd. NE 60382 Arnold, OR
 Salem, OR 97305 Bend, OR 97701
 (503) 585-7593 (503) 382-1001