


SECTION 6, TWP.2 N. RANGE 12 E. W.M.
 WASCO COUNTY, OREGON

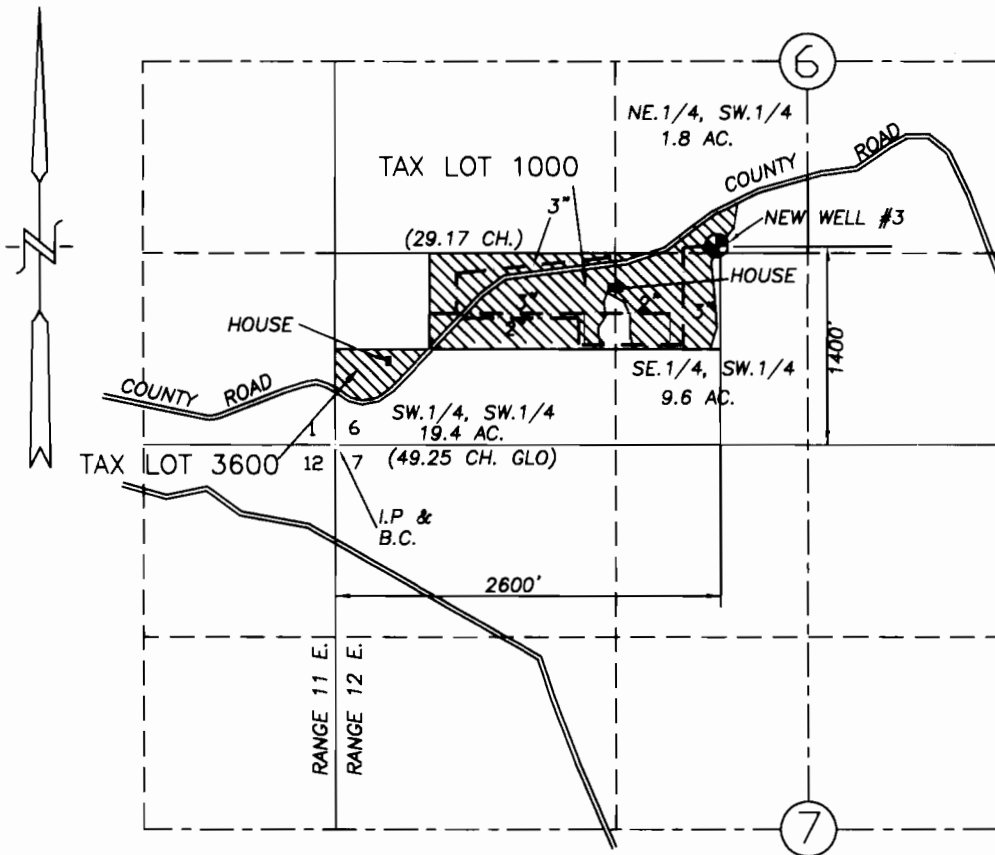

RECORDED
 JUN 16 2004
 WATER RESOURCES DEPT
 SALEM OREGON

 SUPPLEMENTAL IRRIGATION AREA = 30.8 ACRES
 - - - - - EXISTING IRRIGATION MAIN

CLAIM OF BENEFICIAL USE

SCALE: 1" = 1320'


APPLICATION No. G-13486

PERMIT No. G-12648

IN THE NAME OF:

ANITA BYRD GANNON, DBA, BYRD ORCHARDS

DATE: DECEMBER 15, 2004

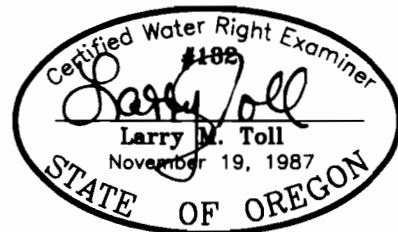

EXPIRES: 06/30/06

NOTE:

"THIS MAP IS NOT INTENDED TO PROVIDE DIMENSIONS OR LOCATIONS OF PROPERTY OWNERSHIP LINES."

TENNESON ENGINEERING CORP.
 CONSULTING ENGINEERS
 409 LINCOLN STREET
 THE DALLES, OREGON 97058
 541-296-9177 FAX 541-296-6657



W.O. #7014b