



TOWNSHIP 16 SOUTH, RANGE 22 EAST, W.M.  
CROOK COUNTY

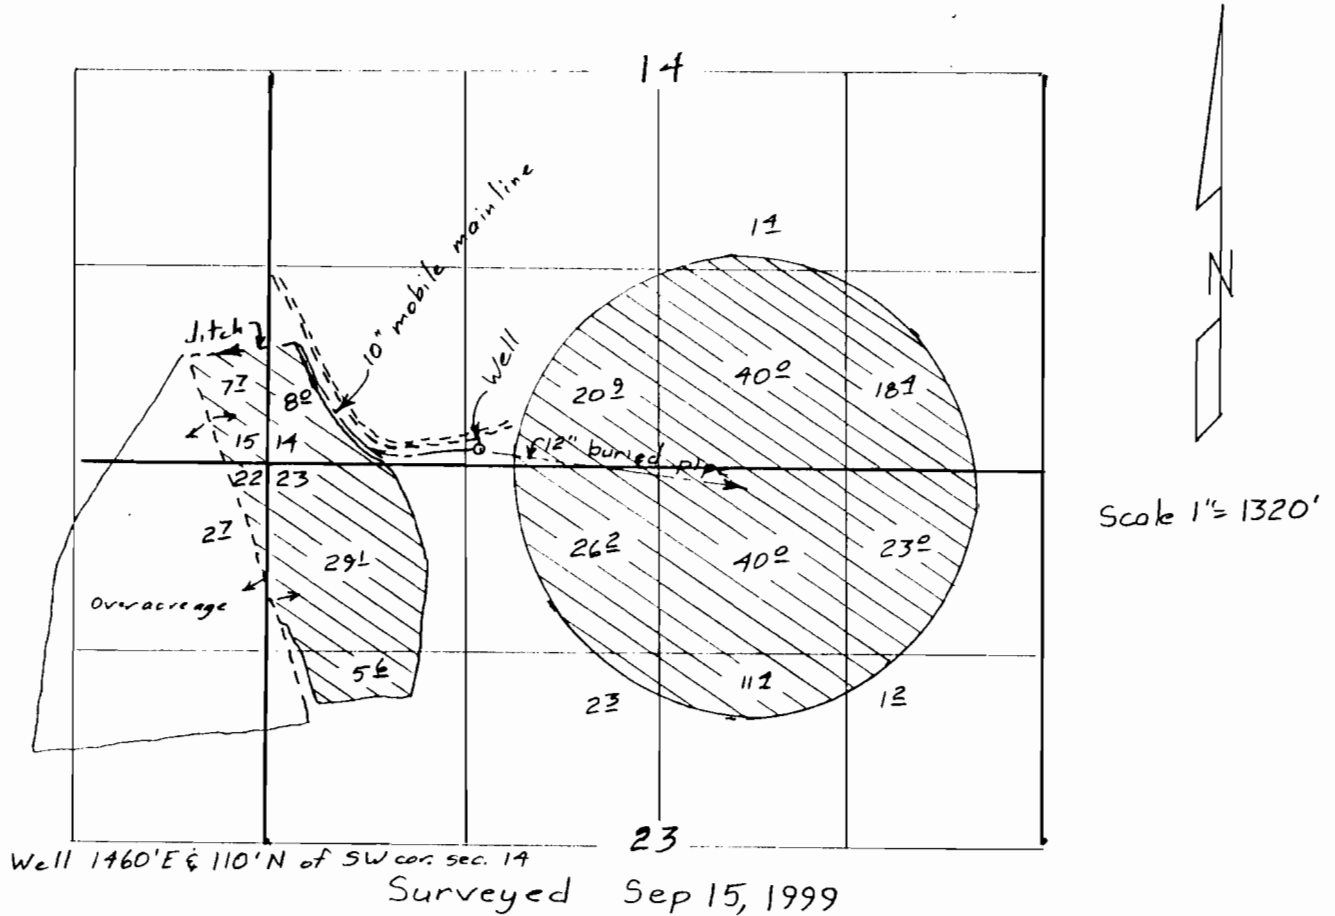

Claim of Beneficial Use Map  
for  
GUTIERREZ CATTLE Co.

App G-13520

Per G-12657

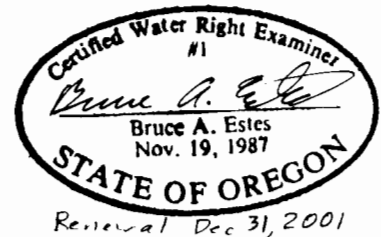

This map is for the purpose of  
locating a water right only  
and has no intent to provide  
legal dimensions or the location  
of property lines.

**ESTES SURVEYS**

PO Box 17519 60382 Arnold Rd  
Salem, OR 97305-7519 Bend, OR 97702  
(503) 585-7593 (541) 382-7391