

FINAL PROOF SURVEY

APPLICATION # G-12287 PERMIT G-12662
 FOR SUPPLEMENTAL USE OF WATER
 IN THE NAME OF
PETER TALBOTT
 17614 TUNNEL HILL RD
 LAKEVIEW, OREGON 97630

RECEIVED

SEP 1 2004




SCALE: 1"=1320'

REVISION BY

**ANDERSON ENGINEERING
 AND SURVEYING, INC.**
 P.O. BOX 28 P.O. BOX 419
 LAKEVIEW, OREGON 97630 REDMOND, OREGON 97756
 (541) 947-4407 (541) 923-4307
 FAX 947-2321 FAX 923-4308

PREPARED FOR:
 PETER TALBOTT
 17614 TUNNEL HILL RD.
 LAKEVIEW, OREGON 97630

SURVEY TIE BRASS CAP AT SECTION CORNER

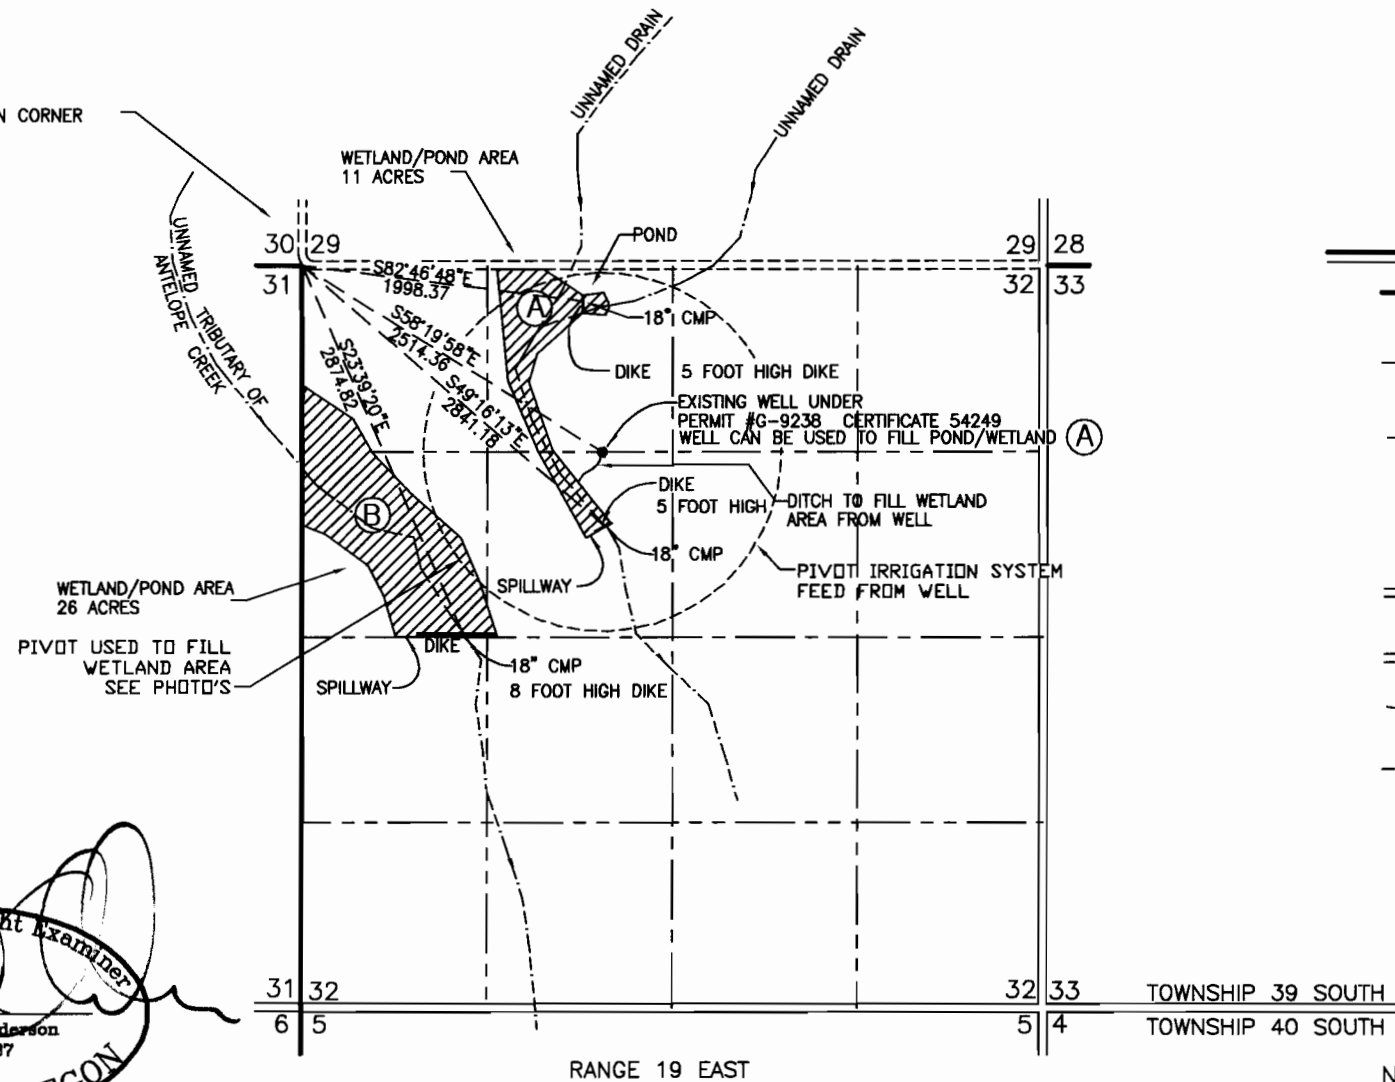

LEGEND

- SECTION LINE
 - 1/4 SECTION LINE
 - 1/16 SECTION LINE
 - RESERVOIR/WETLAND AREAS
 - PAVED COUNTY ROAD
 - UNIMPROVED COUNTY ROAD
 - DRAINAGE/TRIBUTARY
 - SURVEY TIE LINE
- (A) RESERVOIR/WETLANDS CREATED UNDER APPLICATION # R-70859
 MAX. CAPACITY = 5.00 AC-FT.
- (B) RESERVOIR/WETLANDS CREATED UNDER APPLICATION # R-70144
 MAX. CAPACITY = 39.45 AC-FT.

NOTE: PREPARATION OF THIS MAP IS FOR IDENTIFYING PROPOSED WATER RIGHTS ONLY. IT HAS NO INTENT TO PROVIDE LOCATIONS OR DIMENSIONS OF PROPERTY BOUNDARIES.



RENEWAL 12/31/05

DATE: SEPT. 2004
 SCALE: 1" = 1320'
 JOB: 2004-84
 DWG. BY: J.H.
 FILE: 2004-84
 SHEET 1 OF 1