

# FINAL PROOF SURVEY IN SEC 17 T 2 N, R 13 E, WM, WASCO COUNTY, OREGON


RECEIVED

AUG 27 2001

WATER RESOURCES DEPT  
ALEX. OREGON




SCALE IN FEET

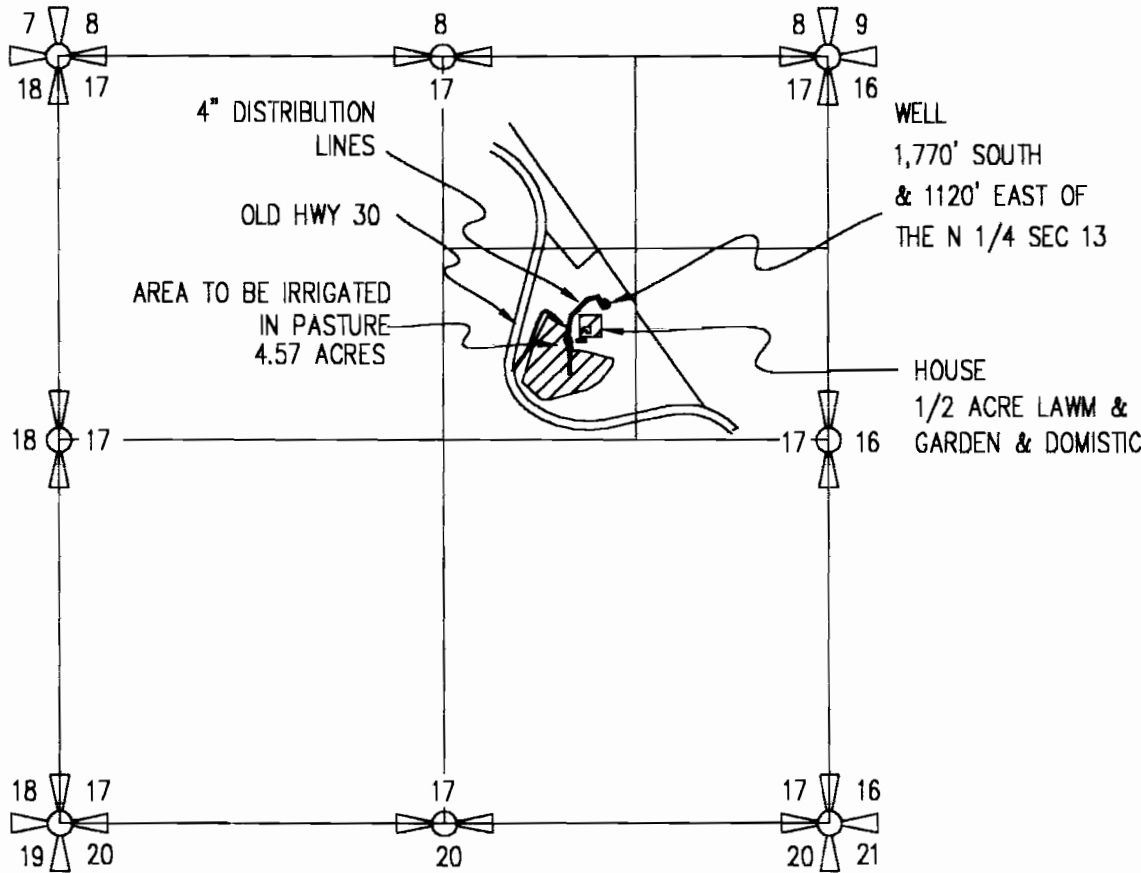

**CERTIFICATE:**

I, ANTHONY C. KLEIN, THE WITHIN REGISTERED WATER RIGHT EXAMINER DO HEREBY CERTIFY THAT THIS MAP WAS PREPARED BY ME AND IS FOR THE PURPOSE OF IDENTIFYING THE LOCATION OF THE WATER RIGHT ONLY AND HAS NO INTENT TO PROVIDE DIMENSIONS OR LOCATION OF PROPERTY OWNERSHIP LINES.

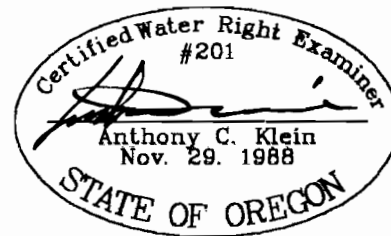

EXPIRES: JUNE 30, 2003

FINAL PROOF  
FOR  
DANNY R. & PATRICIA J.  
LEWIS



## Klein & Assoc.

LAND SURVEYING  
1109 Country Club Road  
Hood River, Oregon 97031

Tele: (503)386-3322

File: G-13515 Permit: G-12667

DATE: AUGUST 1, 2001

JOB NO.: 00056