



RECEIVED

JUN 10 1988

WATER RESOURCES DEPT. SALEM, OREGON

Application No. G-11819
Permit No. G12678

INDIAN FORD RANCH

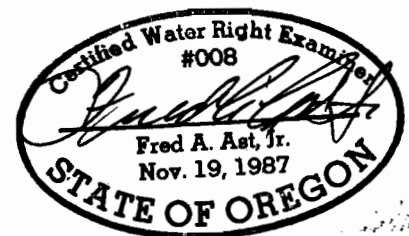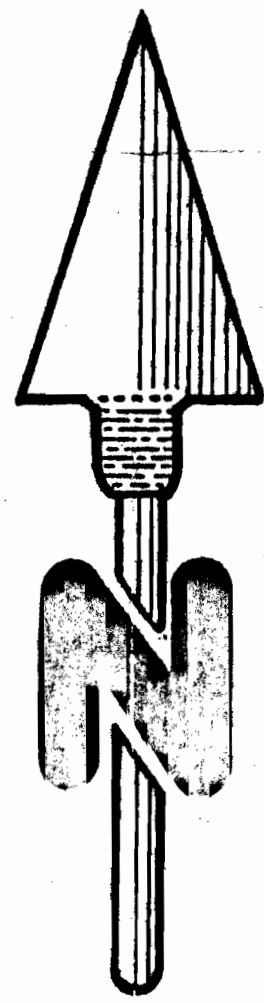


SCALE 1"=300'

MARCH 1981

WATER SYSTEM MASTER PLAN

Updated: 4-6-82

SISTERS HOME REPAIR
P. O. Box 696
SISTERS, OREGON 97759
(803) 549-3252

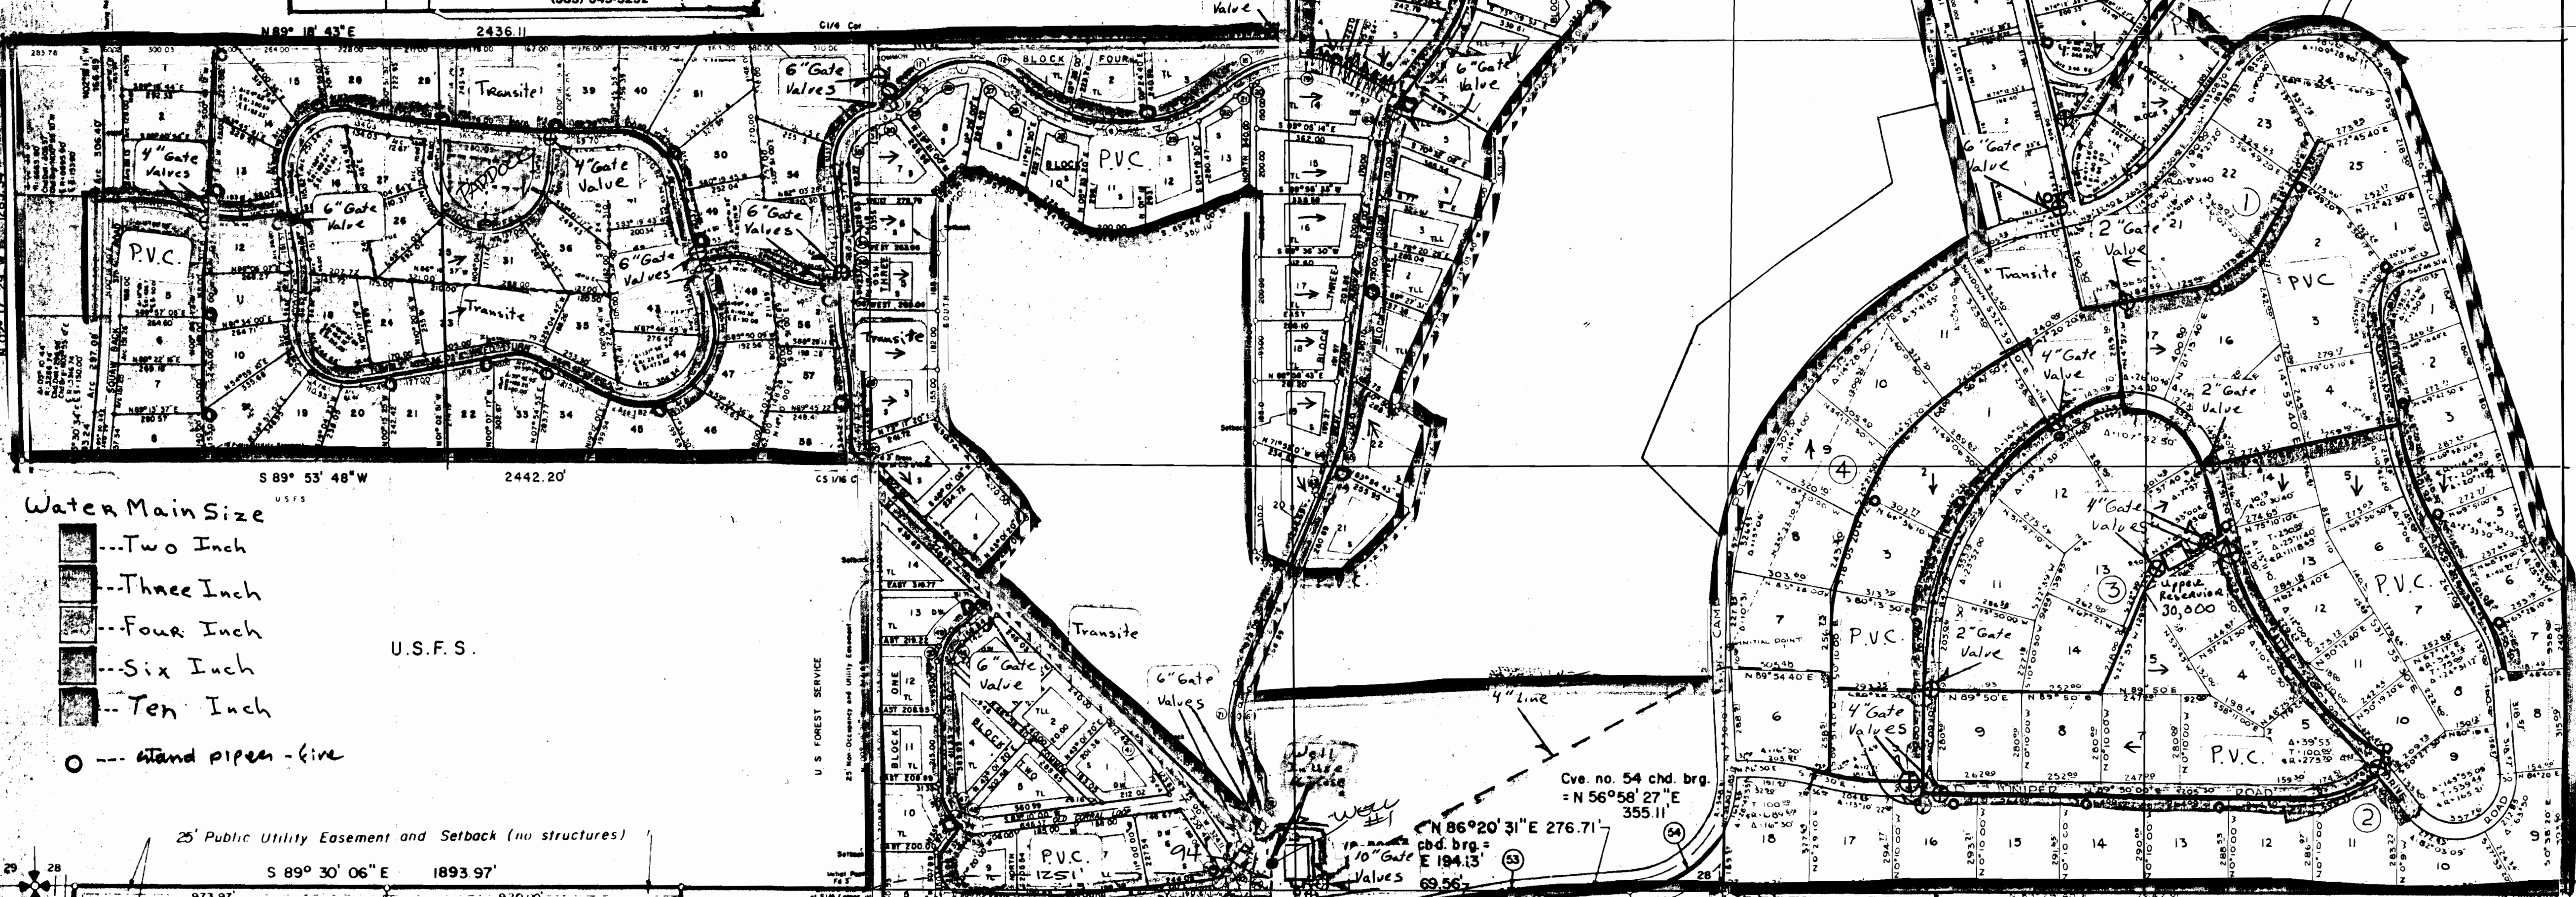

- Water Main Size
- Two Inch
 - Three Inch
 - Four Inch
 - Six Inch
 - Ten Inch
 - Stand pipe - five

