

NW 1/4 SW 1/4

NE 1/4 SW 1/4

3.69 ACRES  
IRRIGATION, NURSERY  
OPERATIONS

3.25 ACRES  
IRRIGATION, NURSERY  
OPERATIONS

MOUNT HOOD HIGHWAY

WELL

BURIED 3" DIAMETER  
PLASTIC MAINLINE  
AND LATERALS

This drawing is an exhibit for a Final Proof Survey.  
It is not a Land Survey. Property lines and/or other  
lines of occupation shown hereon are not represented  
by the undersigned to meet accuracy standards of  
Land Surveys.

282ND AVENUE

1909'  
N18°41'42"E

SW 1/4 SW 1/4

RECEIVED

MAY 24 1999


WATER RESOURCES DEPT.  
SALEM, OREGON



SCALE: 1" = 400'


25 30  
36 31

SECTIONS 30, T.1S., R.4E., W.M.  
CLACKAMAS COUNTY, OREGON

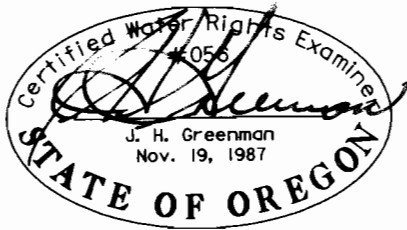

Application No. G-13935

Permit No. G-12682

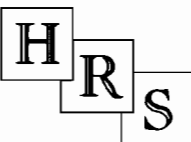

**HANER, ROSS &  
SPORSEEN, INC.**

15 S.E. 82ND DRIVE  
GLADSTONE, OREGON 97027

**CHRISTOPHER REARDON**

**FINAL PROOF SURVEY**

630DD