


TOWNSHIP 12 SOUTH, RANGE 3 WEST, W.M.

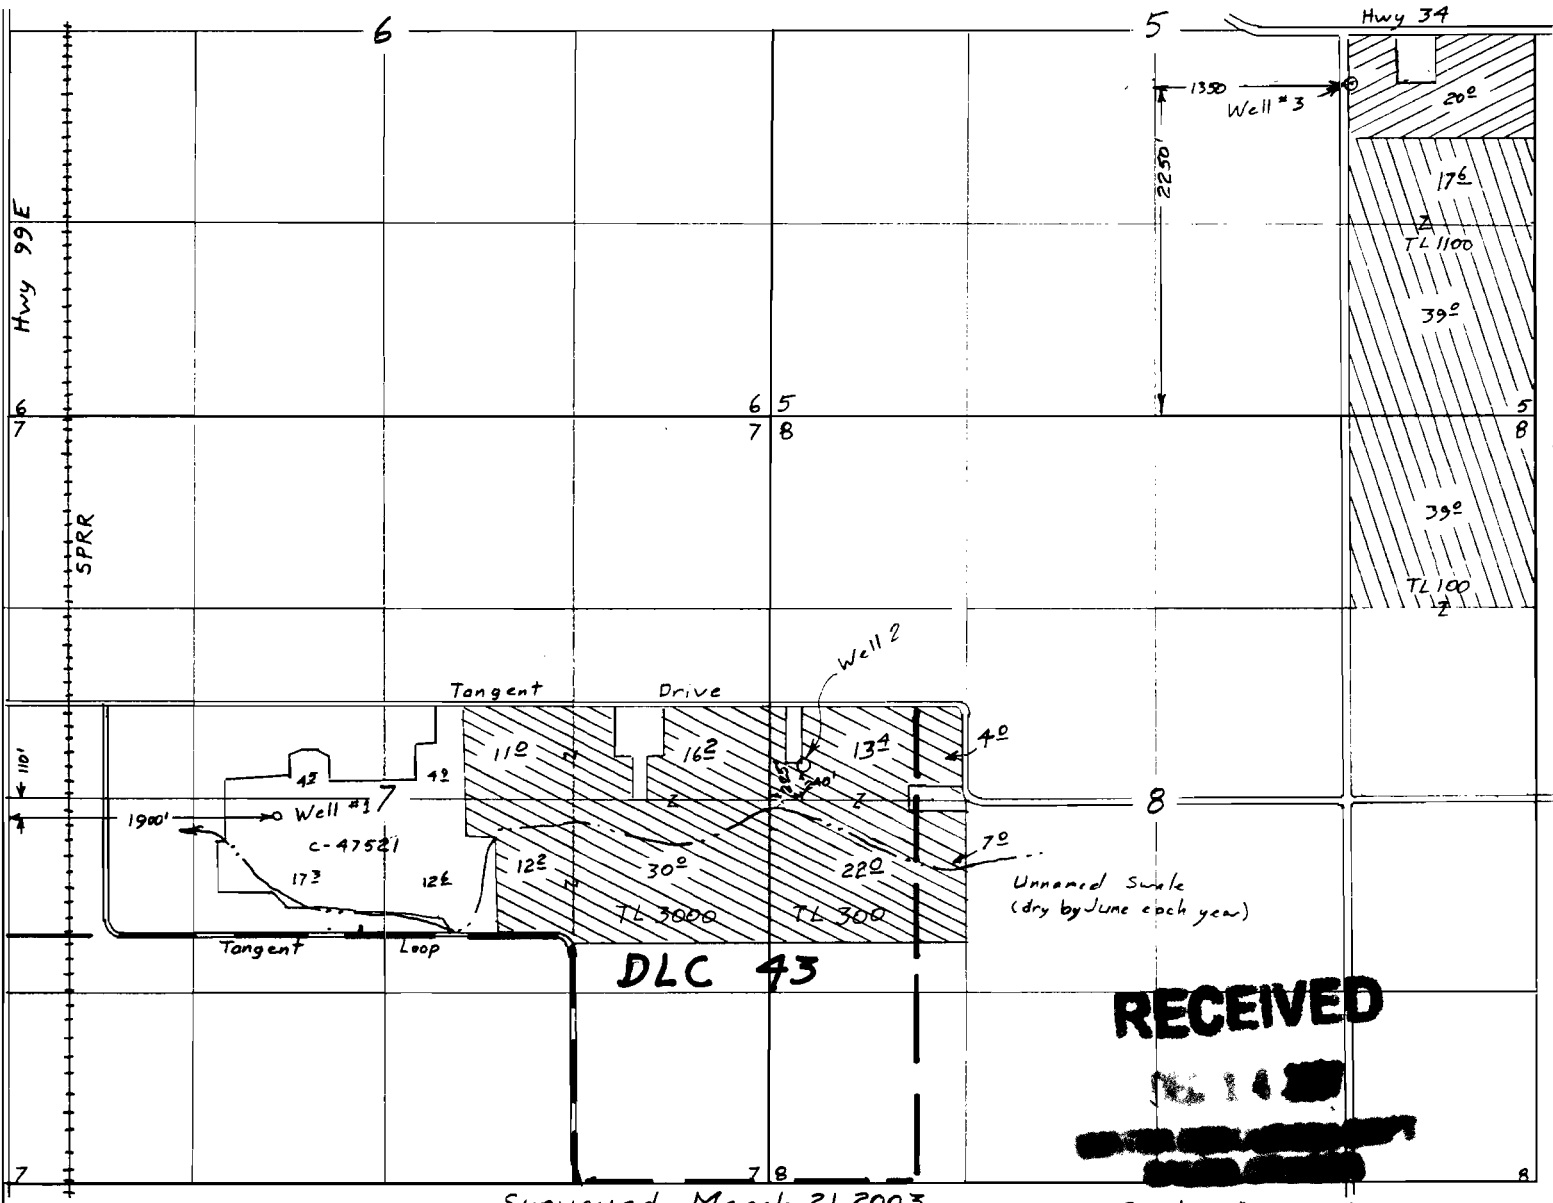


Surveyed March 21, 2003

Scale 1" = 1320'

Claim of Beneficial
Use Map
for

STEVE GLASER FARM, INC.

- Well 2 irrigation
- Well 3 irrigation
- Well 3 nursery & irrigation

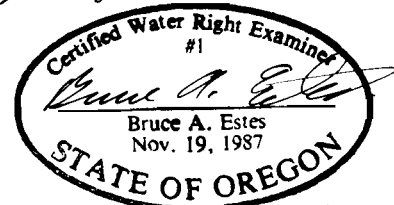

Renewal Dec 31, 2003

App. G-14143

Per. G-12686

This map is for the purpose of
locating a water right only
and has no intent to provide
legal dimensions or the location
of property lines.

ESTES SURVEYS, LLC

6293 Sunnyview Rd. NE
Salem, OR 97305
(503) 585-7593

60382 Arnold Rd
Bend, OR 97702
(503) 382-7391