

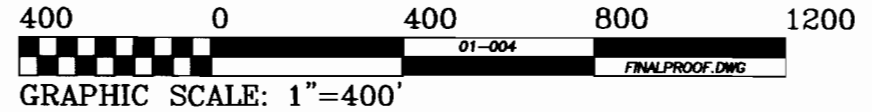
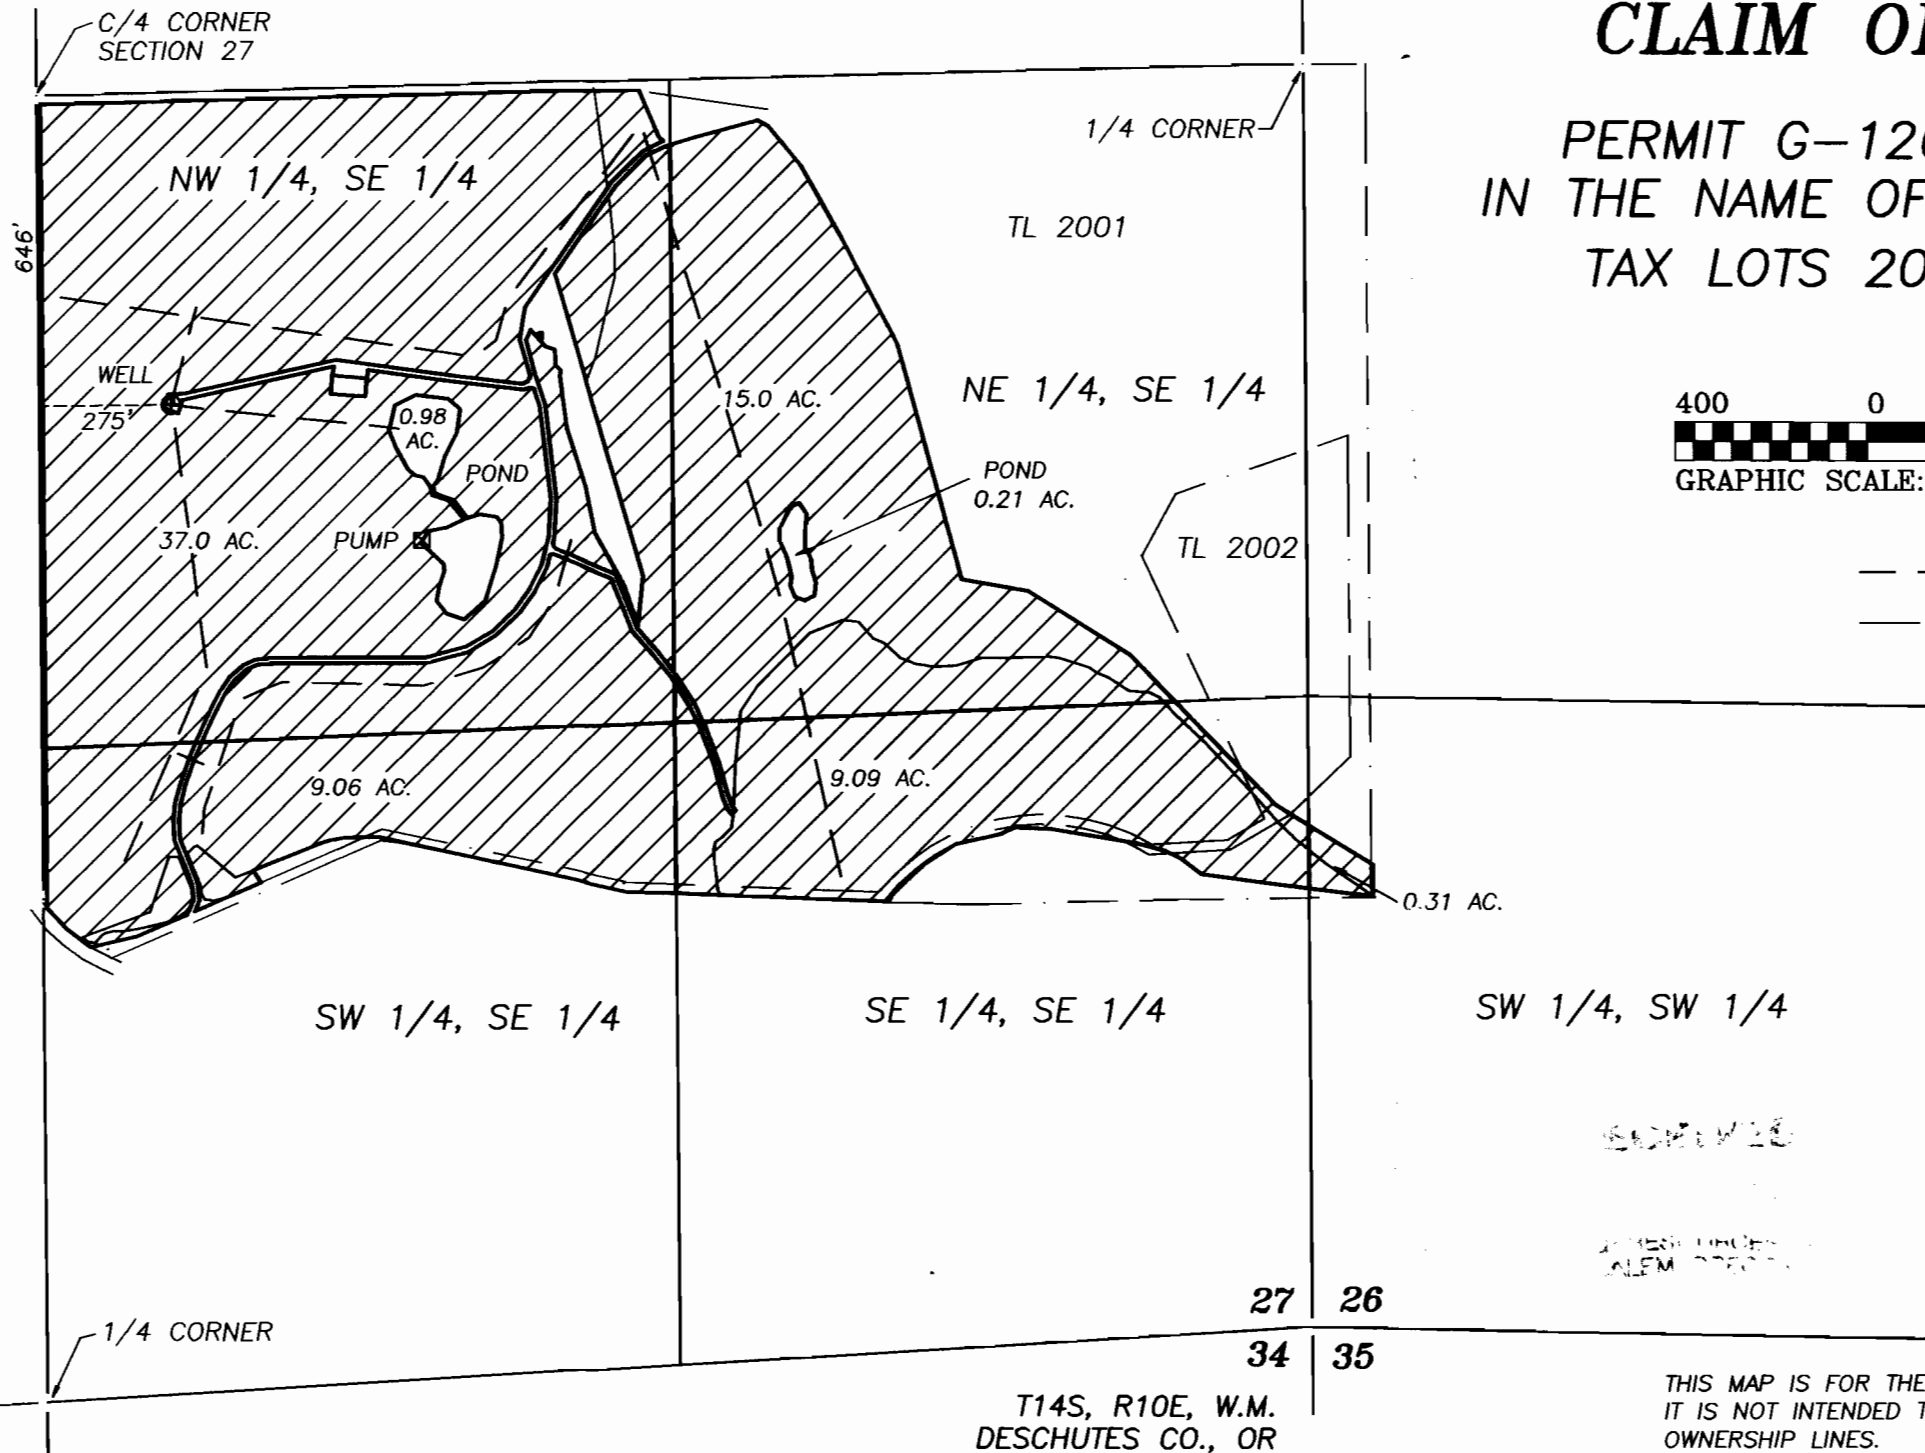


FINAL PROOF SURVEY CLAIM OF BENEFICIAL USE

PERMIT G-12699, APPLICATION G-13763
IN THE NAME OF DARK HORSE FINANCIAL, INC.
TAX LOTS 2001, 2002, MAP 14-1027D

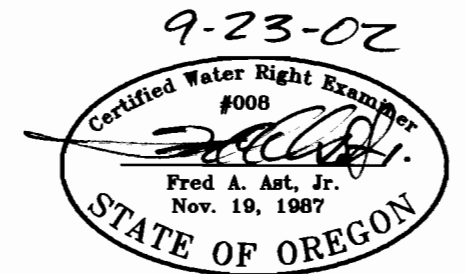

--- 6" MAINLINES
--- PARCEL BOUNDARY

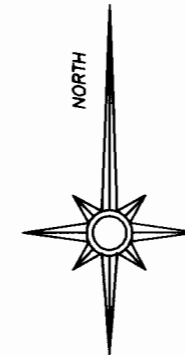

THIS MAP IS FOR THE PURPOSE OF IDENTIFYING THE LOCATION OF THE WATER RIGHT.
IT IS NOT INTENDED TO PROVIDE LEGAL DIMENSIONS OR LOCATIONS OF PROPERTY
OWNERSHIP LINES.