


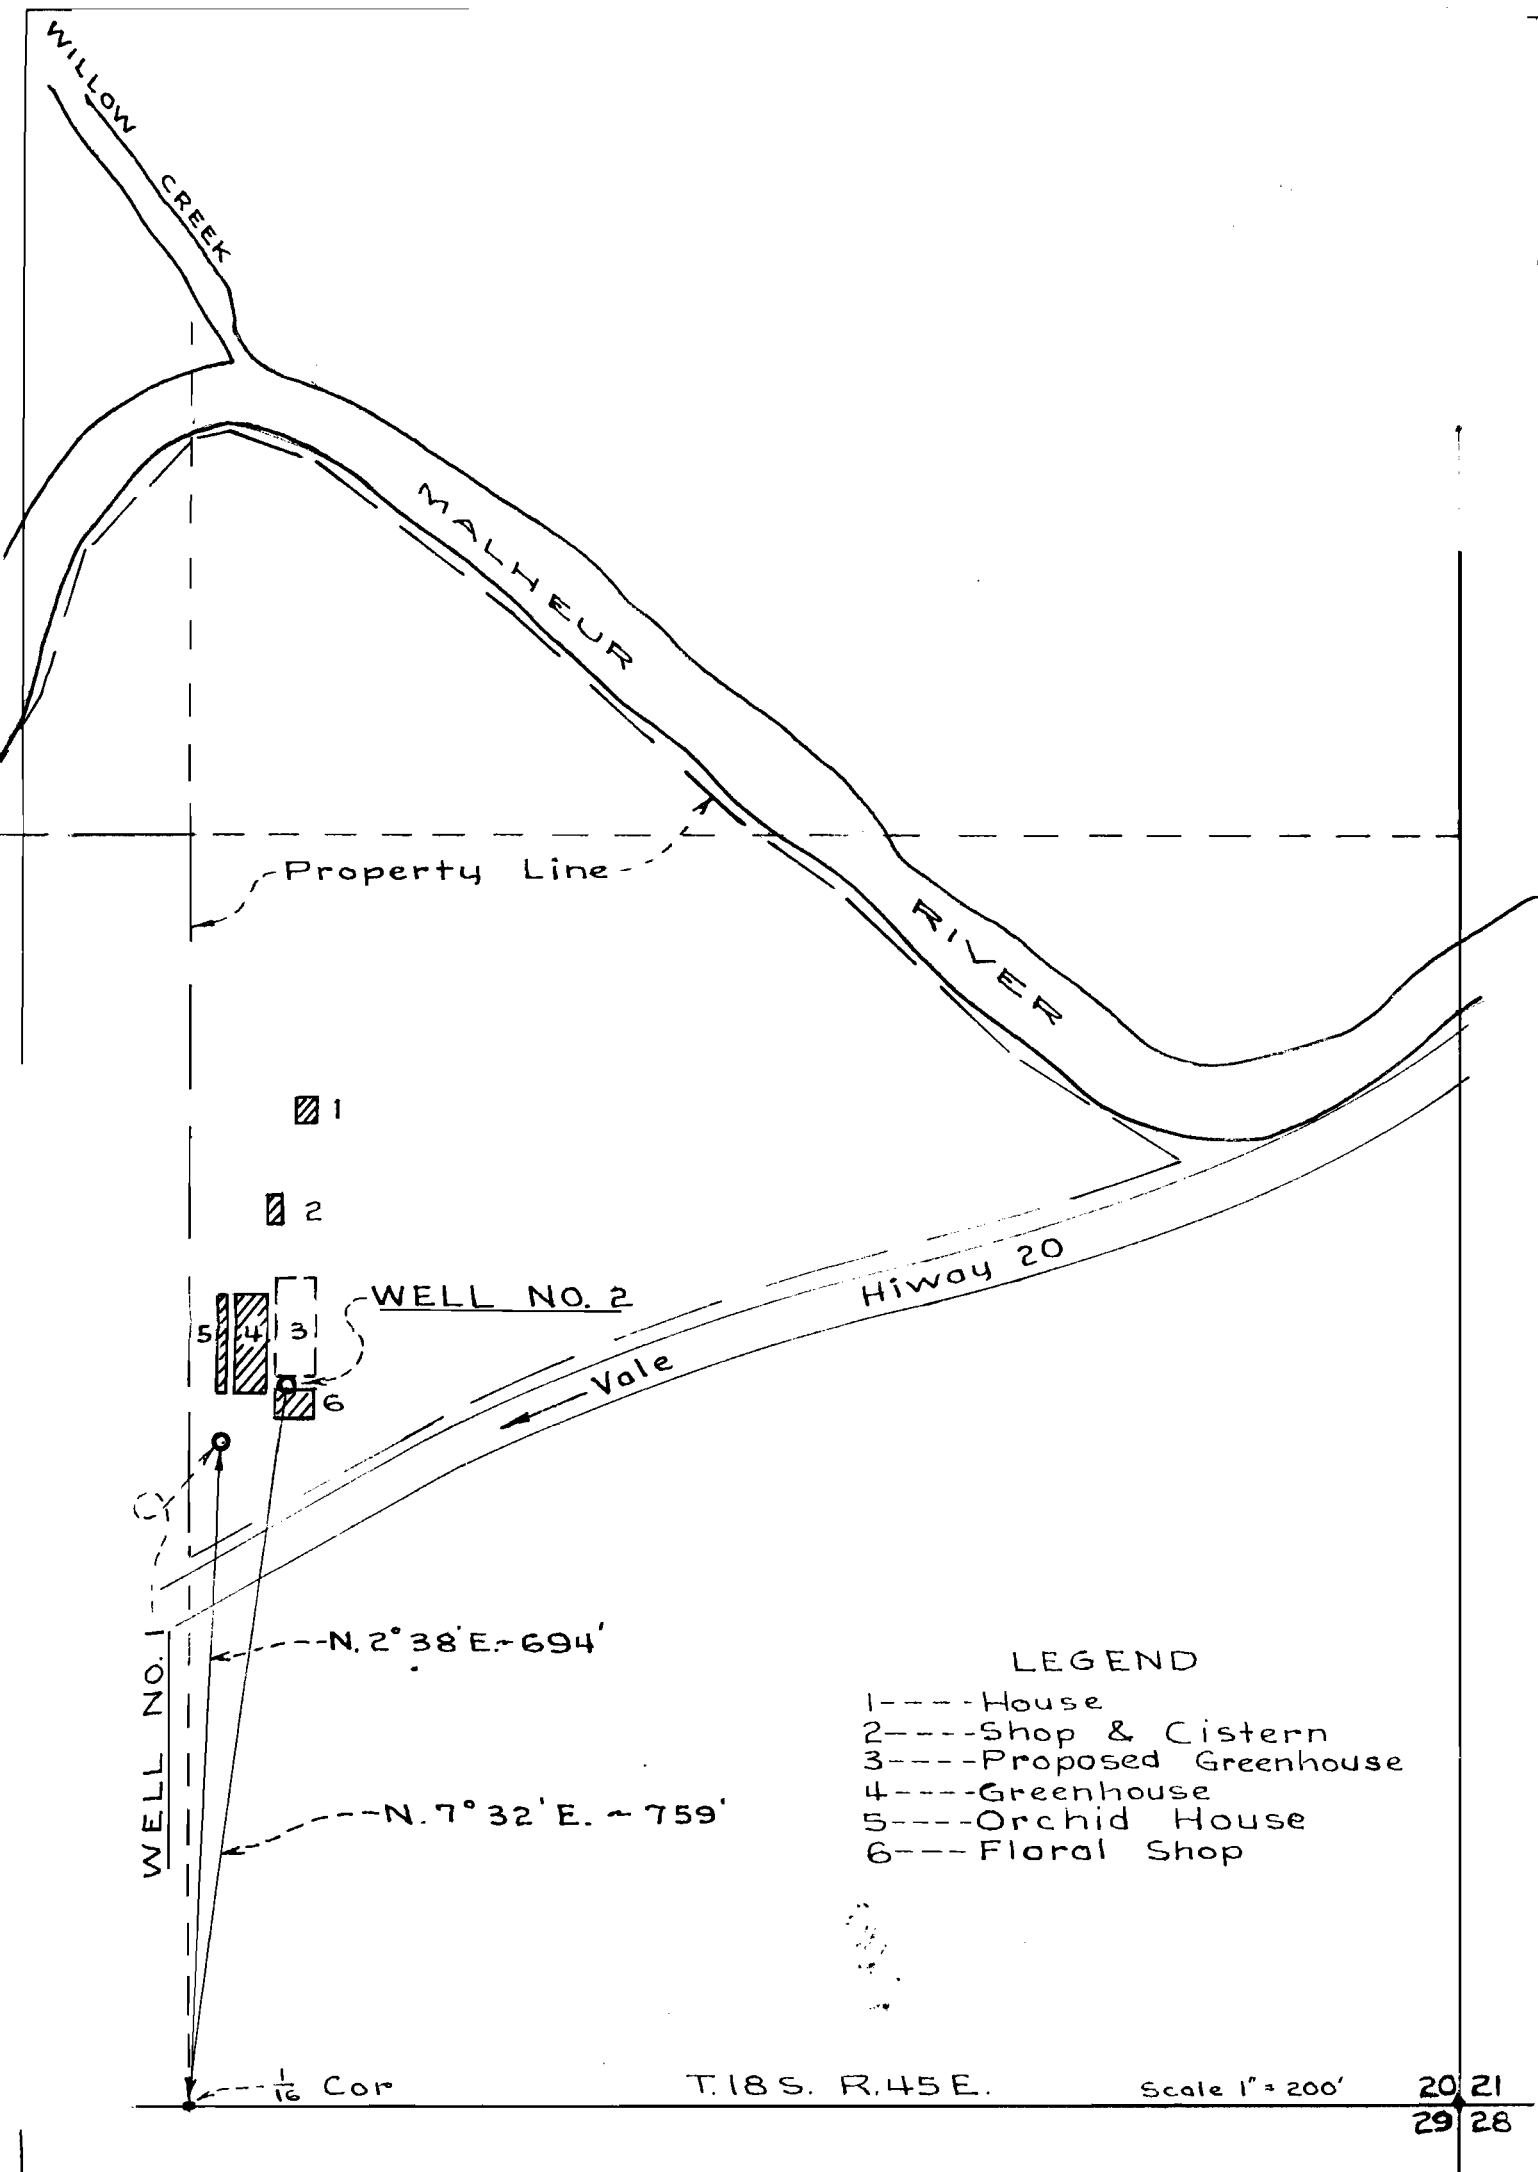

Application No. G-1376 APPLICATION FOR PERMIT
 Permit No. G-1270 C.B. Fuhrman ~ Vale, Ore.