
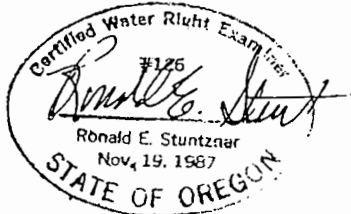


Water Rights Application Map
 SE 1/4 SE 1/4, Section 33,
 TOWNSHIP 27S, RANGE 14W, W. M.
 Coos County, Oregon

RECEIVED

APR - 8 1994

WATER RESOURCES DEPT.

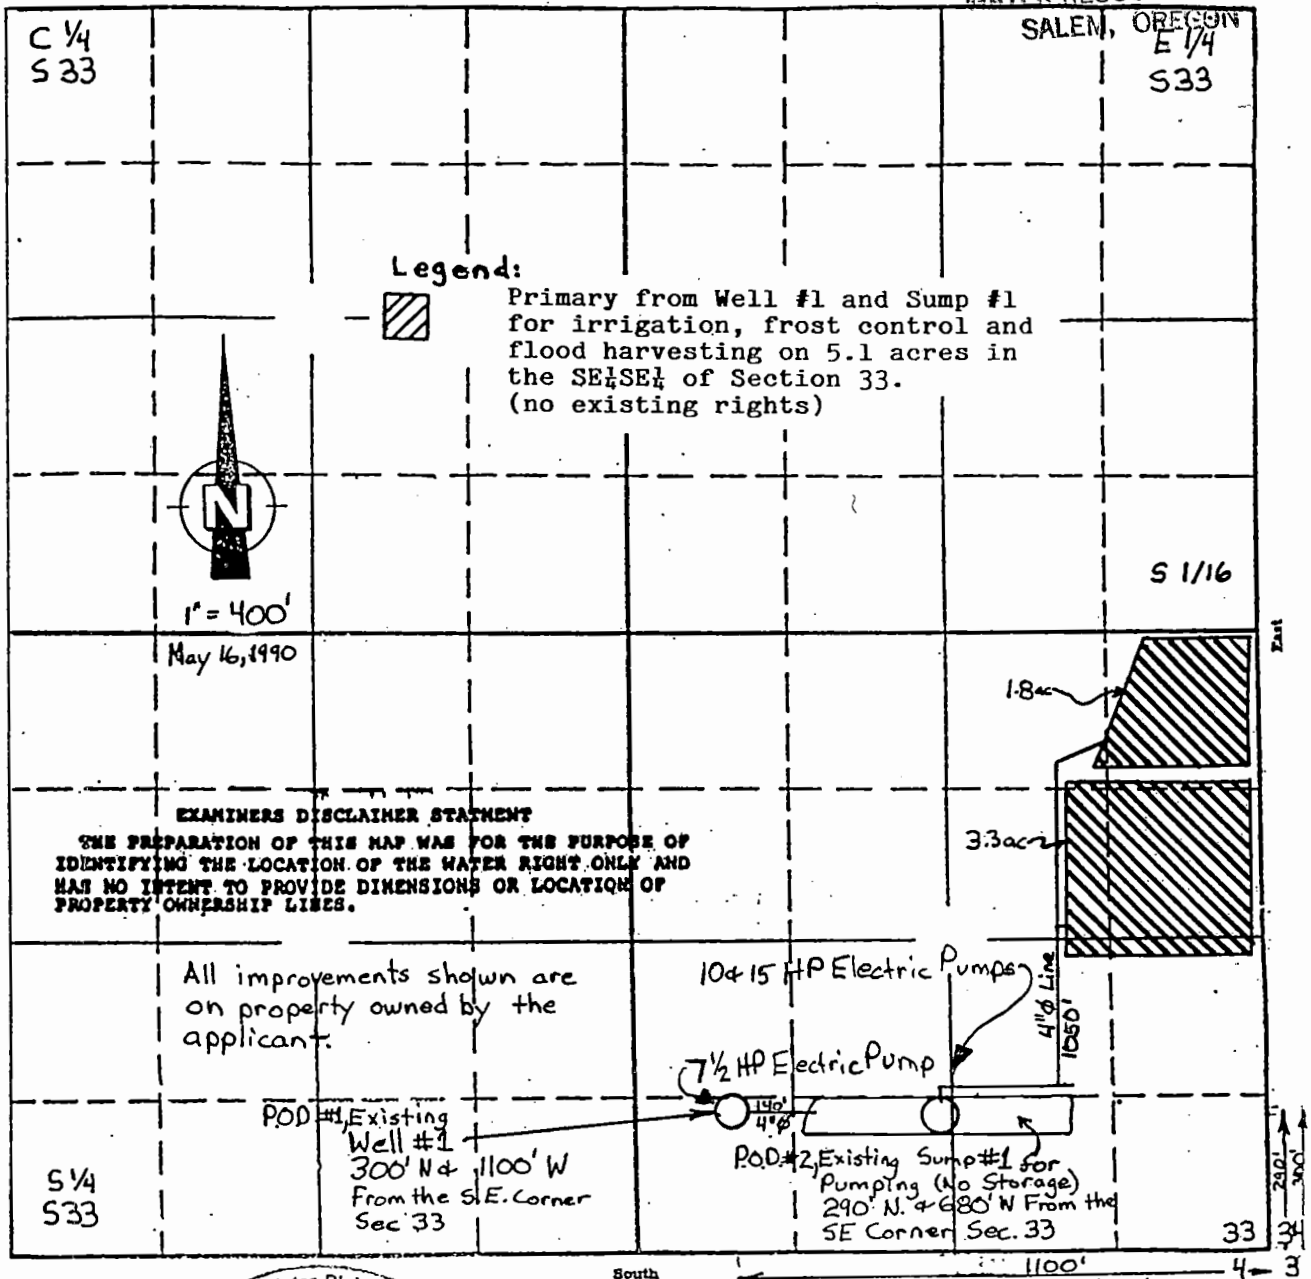

APPLICATION No.
 PERMIT No.
 Stuntzner Engineering & Forestry
 TELEPHONE 267-2872
 705 SO. 4TH, P.O. BOX 118 - COOS BAY, OREGON 97426

Application No. G-13660
 Permit No. G12702