



TOWNSHIP 15 SOUTH, RANGE 10 EAST, W.M.

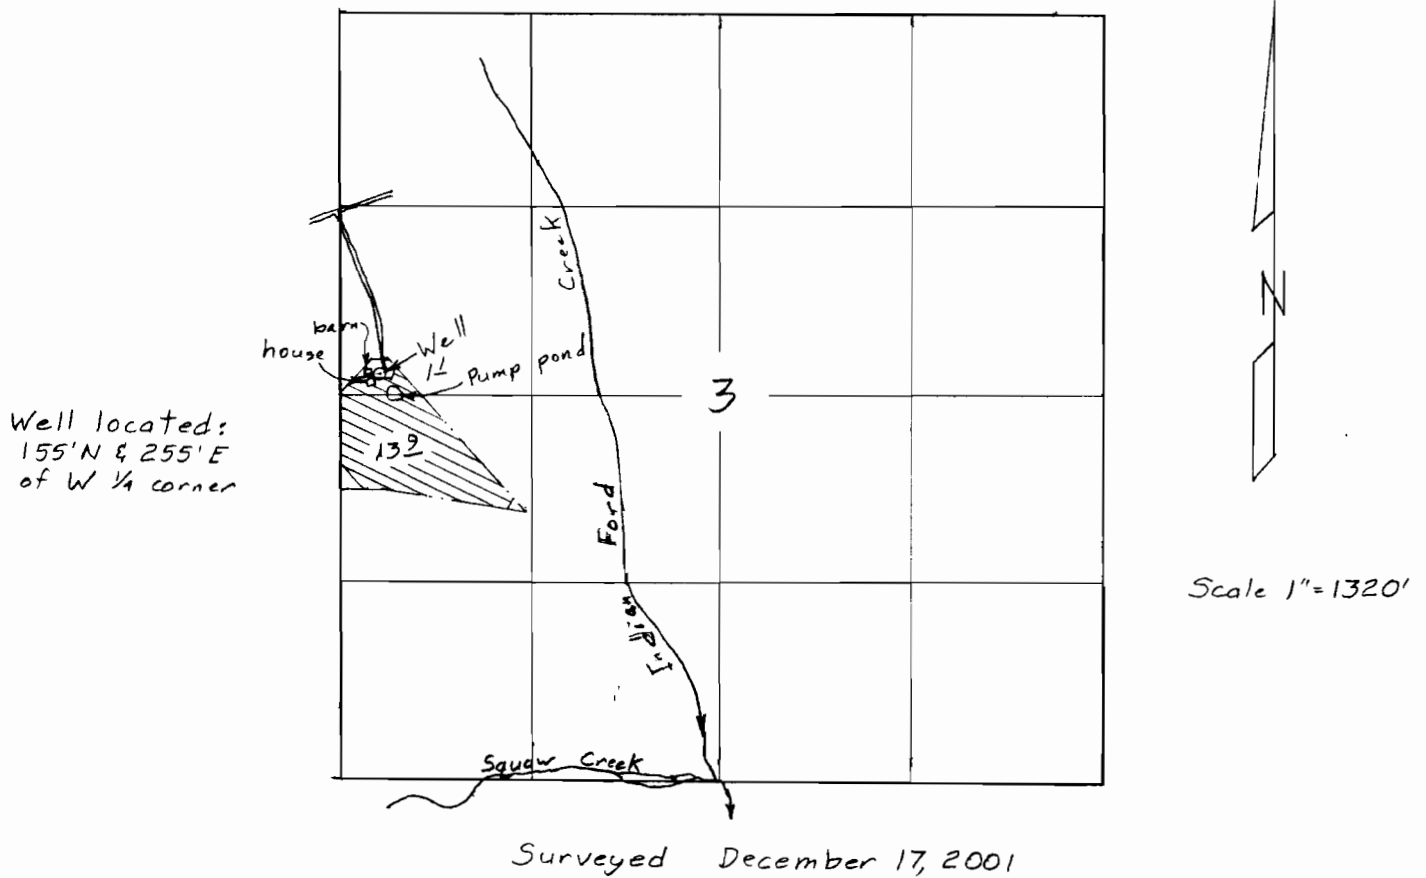

Well located:  
155' N & 255' E  
of W 1/4 corner

Claim of Beneficial Use Map  
for  
TONY BLOK

App G-14083  
Per G-12717

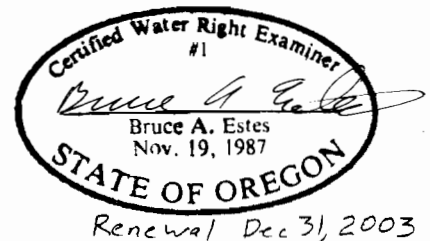

This map is for the purpose of  
locating a water right only  
and has no intent to provide  
legal dimensions or the location  
of property lines.

**ESTES SURVEYS, LLC**

PO Box 17519      60382 Arnold Rd  
Salem, OR 97305-7519      Bend, OR 97702  
(503) 585-7593      (541) 382-7391