


T 22 S, R 31 E, WM T 23 S,

RECEIVED

SEP 20 2000

WATER RESOURCES DEPT
SALEM, OREGON


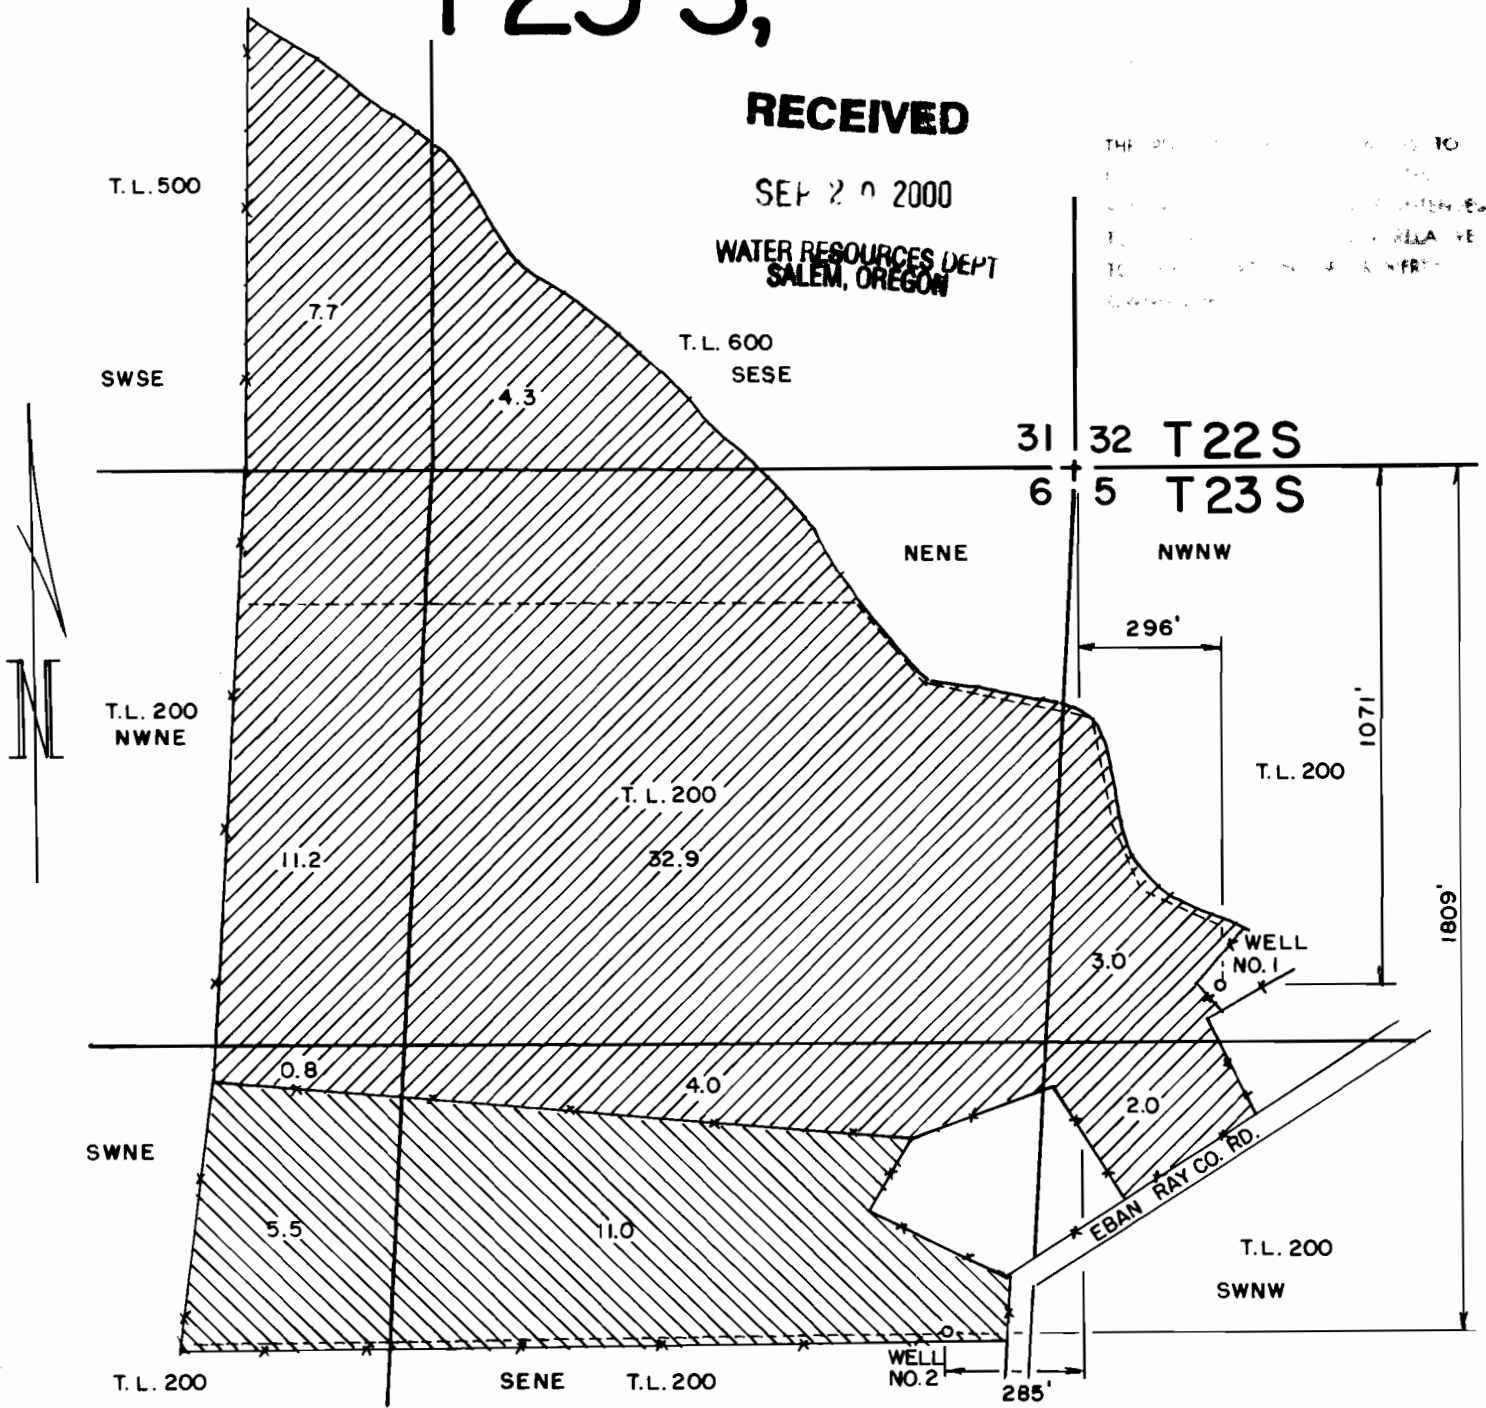

FINAL PROOF SURVEY

UNDER
APPLICATION NO. G-13971
PERMIT NO. G-12720

IN THE NAME OF
WILLIAM & NORMA
SPRINGSTON

Scale: 1" = 400'

Date: SEPT. 2000

Job: 1509-00

Dsn:

Drn: CHRIS

Ckd:



M.A. PALMER & SONS, INC.
ENGINEERING & SURVEYING
711 Ponderosa Village • Box 61
Burns, Oregon 97720

Sht. No.

of 1

C. Warner

RENEW 1-1-2001