


Primary lands being irrigated by new well.

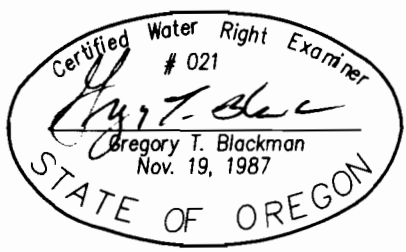

FINAL PROOF MAP OF
WATER RIGHTS
FOR
ELWYN BINGAMAN

BY
BAGETT - GRIFFITH & ASSOCIATES
2006 ADAMS AVENUE
LAGRANDE, OREGON 97850

January 23, 2004

NOTE: The preparation of this map was for the purpose of identifying the location of the proposed water right and has no intent to provide dimensions or location of property ownership lines. Location information shown hereon was furnished by the applicant

APPLICATION NO. G-13878
PERMIT NUMBER G-12738