


TOWNSHIP 18 SOUTH, RANGE 12 EAST, W.M.  
SECTION 24

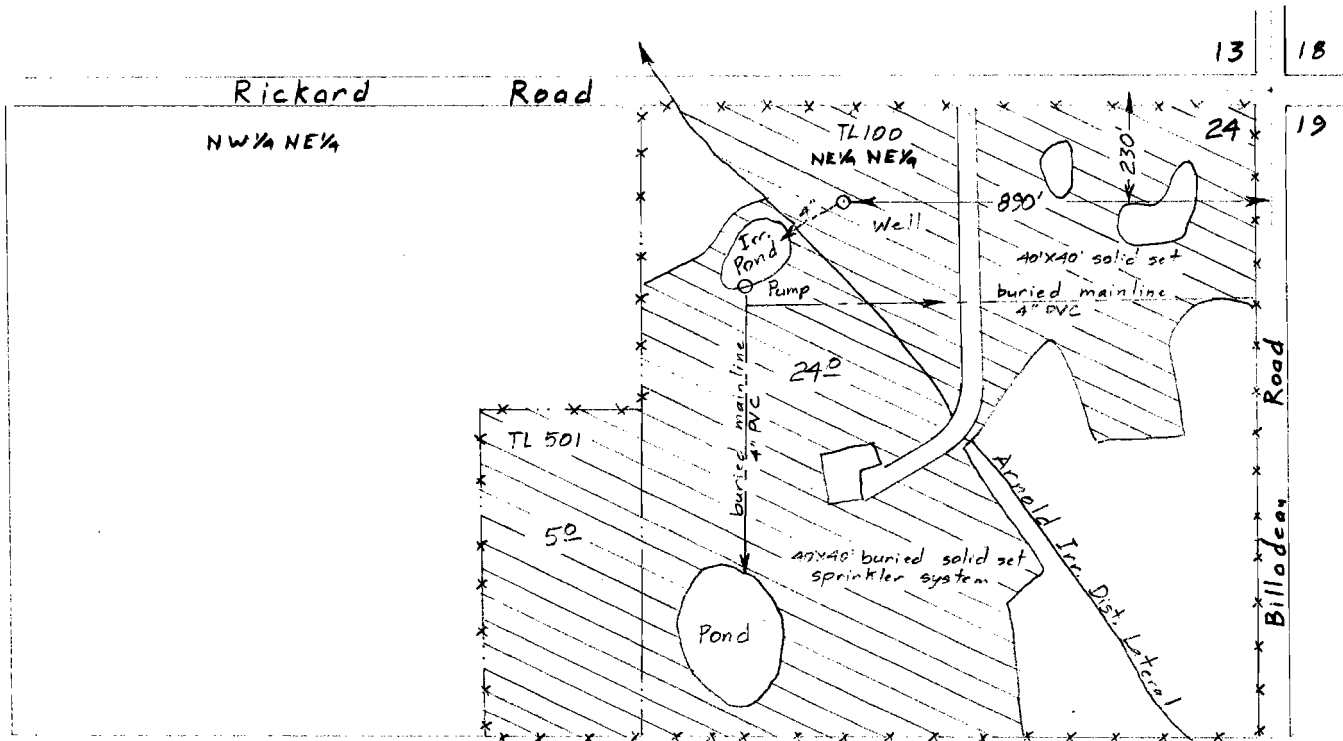

Surveyed September 1, 1998

Scale 1" = 400'


Claim of Beneficial Use Map  
for  
**HAP TAYLOR**

**RECEIVED**

SEP 29 1998

WATER RESOURCES DEPT.  
SALEM, OREGON

Application G-13767  
Permit G-12742

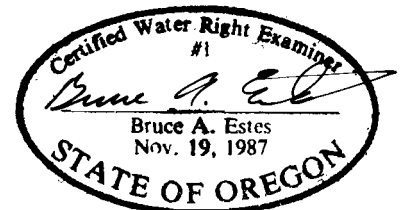

This map is for the purpose of locating a water right only and has no intent to provide legal dimensions or the location of property lines.

**ESTES SURVEYS**

6293 Sunnyview Rd. NE Salem, OR 97305 (503) 585-7593  
60382 Arnold Rd. Bend, OR 97702 (503) 382-7391