


RECEIVED


SEP 28 2000

WATER RESOURCES DEPT.
SALEM OREGON

**FINAL PROOF MAP FOR
PERMIT NO. G-12744
APPLICATION NO. G-13838
SUPPLEMENTAL WATER RIGHT
FOR MICHAEL & JAMIE VAVRINEC**

In The NW 1/4 of Section 17,
Township 15 South, Range 11 East,
W.M., Deschutes County, Oregon

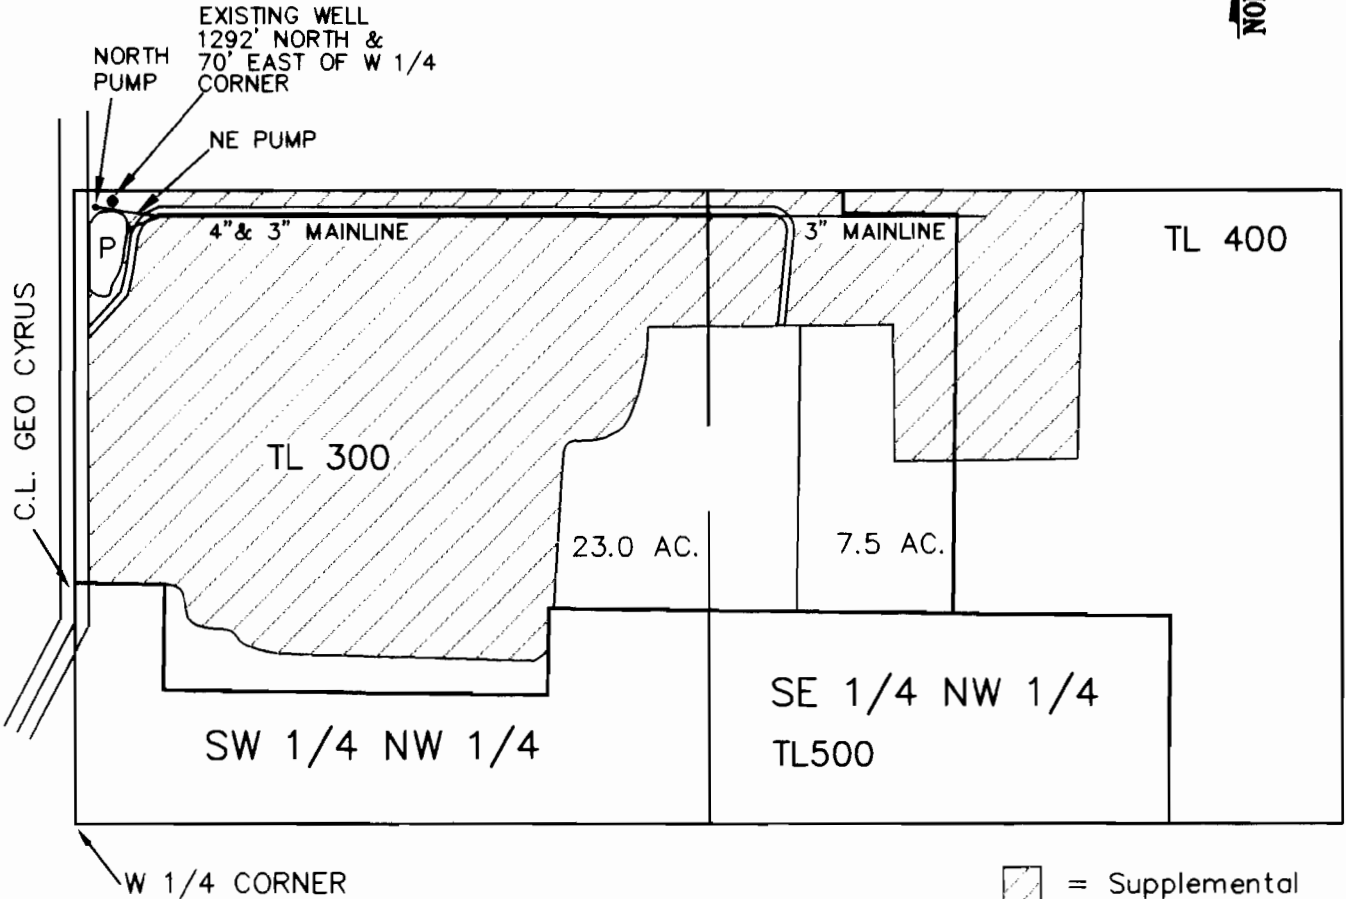

 = Supplemental Water Rights

I, James R. Tye, Certified Water Right Examiner in the State of Oregon, hereby certify that this water rights survey map was prepared under my direct supervision.

The preparation of this map is for the purpose of identifying the location of the water right only and has no intent to provide dimensions or locations of property ownership lines.



SCALE 1"=400' | DATE 9-21-00 | SURVEY BY AERIAL | DRAWN BY S.R.K. | ORDER NO. 2975-22C

SUN COUNTRY ENGINEERING & SURVEYING, INC.
920 SE ARMOUR ROAD BEND, OREGON 97702 PHONE 382-8882