


THIS MAP WAS PREPARED FOR THE PURPOSE OF IDENTIFYING THE LOCATION OF THE WATER RIGHT AND IS NOT INTENDED TO PROVIDE LEGAL DIMENSIONS OR LOCATIONS OF PROPERTY OWNERSHIP LINES.

T20S; R10E

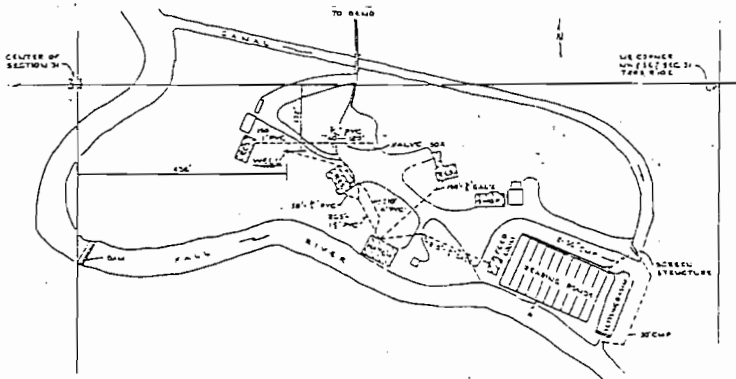

SCALE: 1" = 400'

Robert O. Dodge

**FINAL PROOF SURVEY
UNDER**

APPLICATION NO. G-13927 PERMIT NO. G-12749
IN NAME OF

OREGON DEPARTMENT OF FISH AND WILDLIFE

SURVEYED: 7/17/97 BY: DODGE