


DECISION
FEB 20 1959
STATE ENGINEERING
SALEM, OREGON

SCALE 1" = 200 ft. NE 1/4 SEC 10-
1N1E

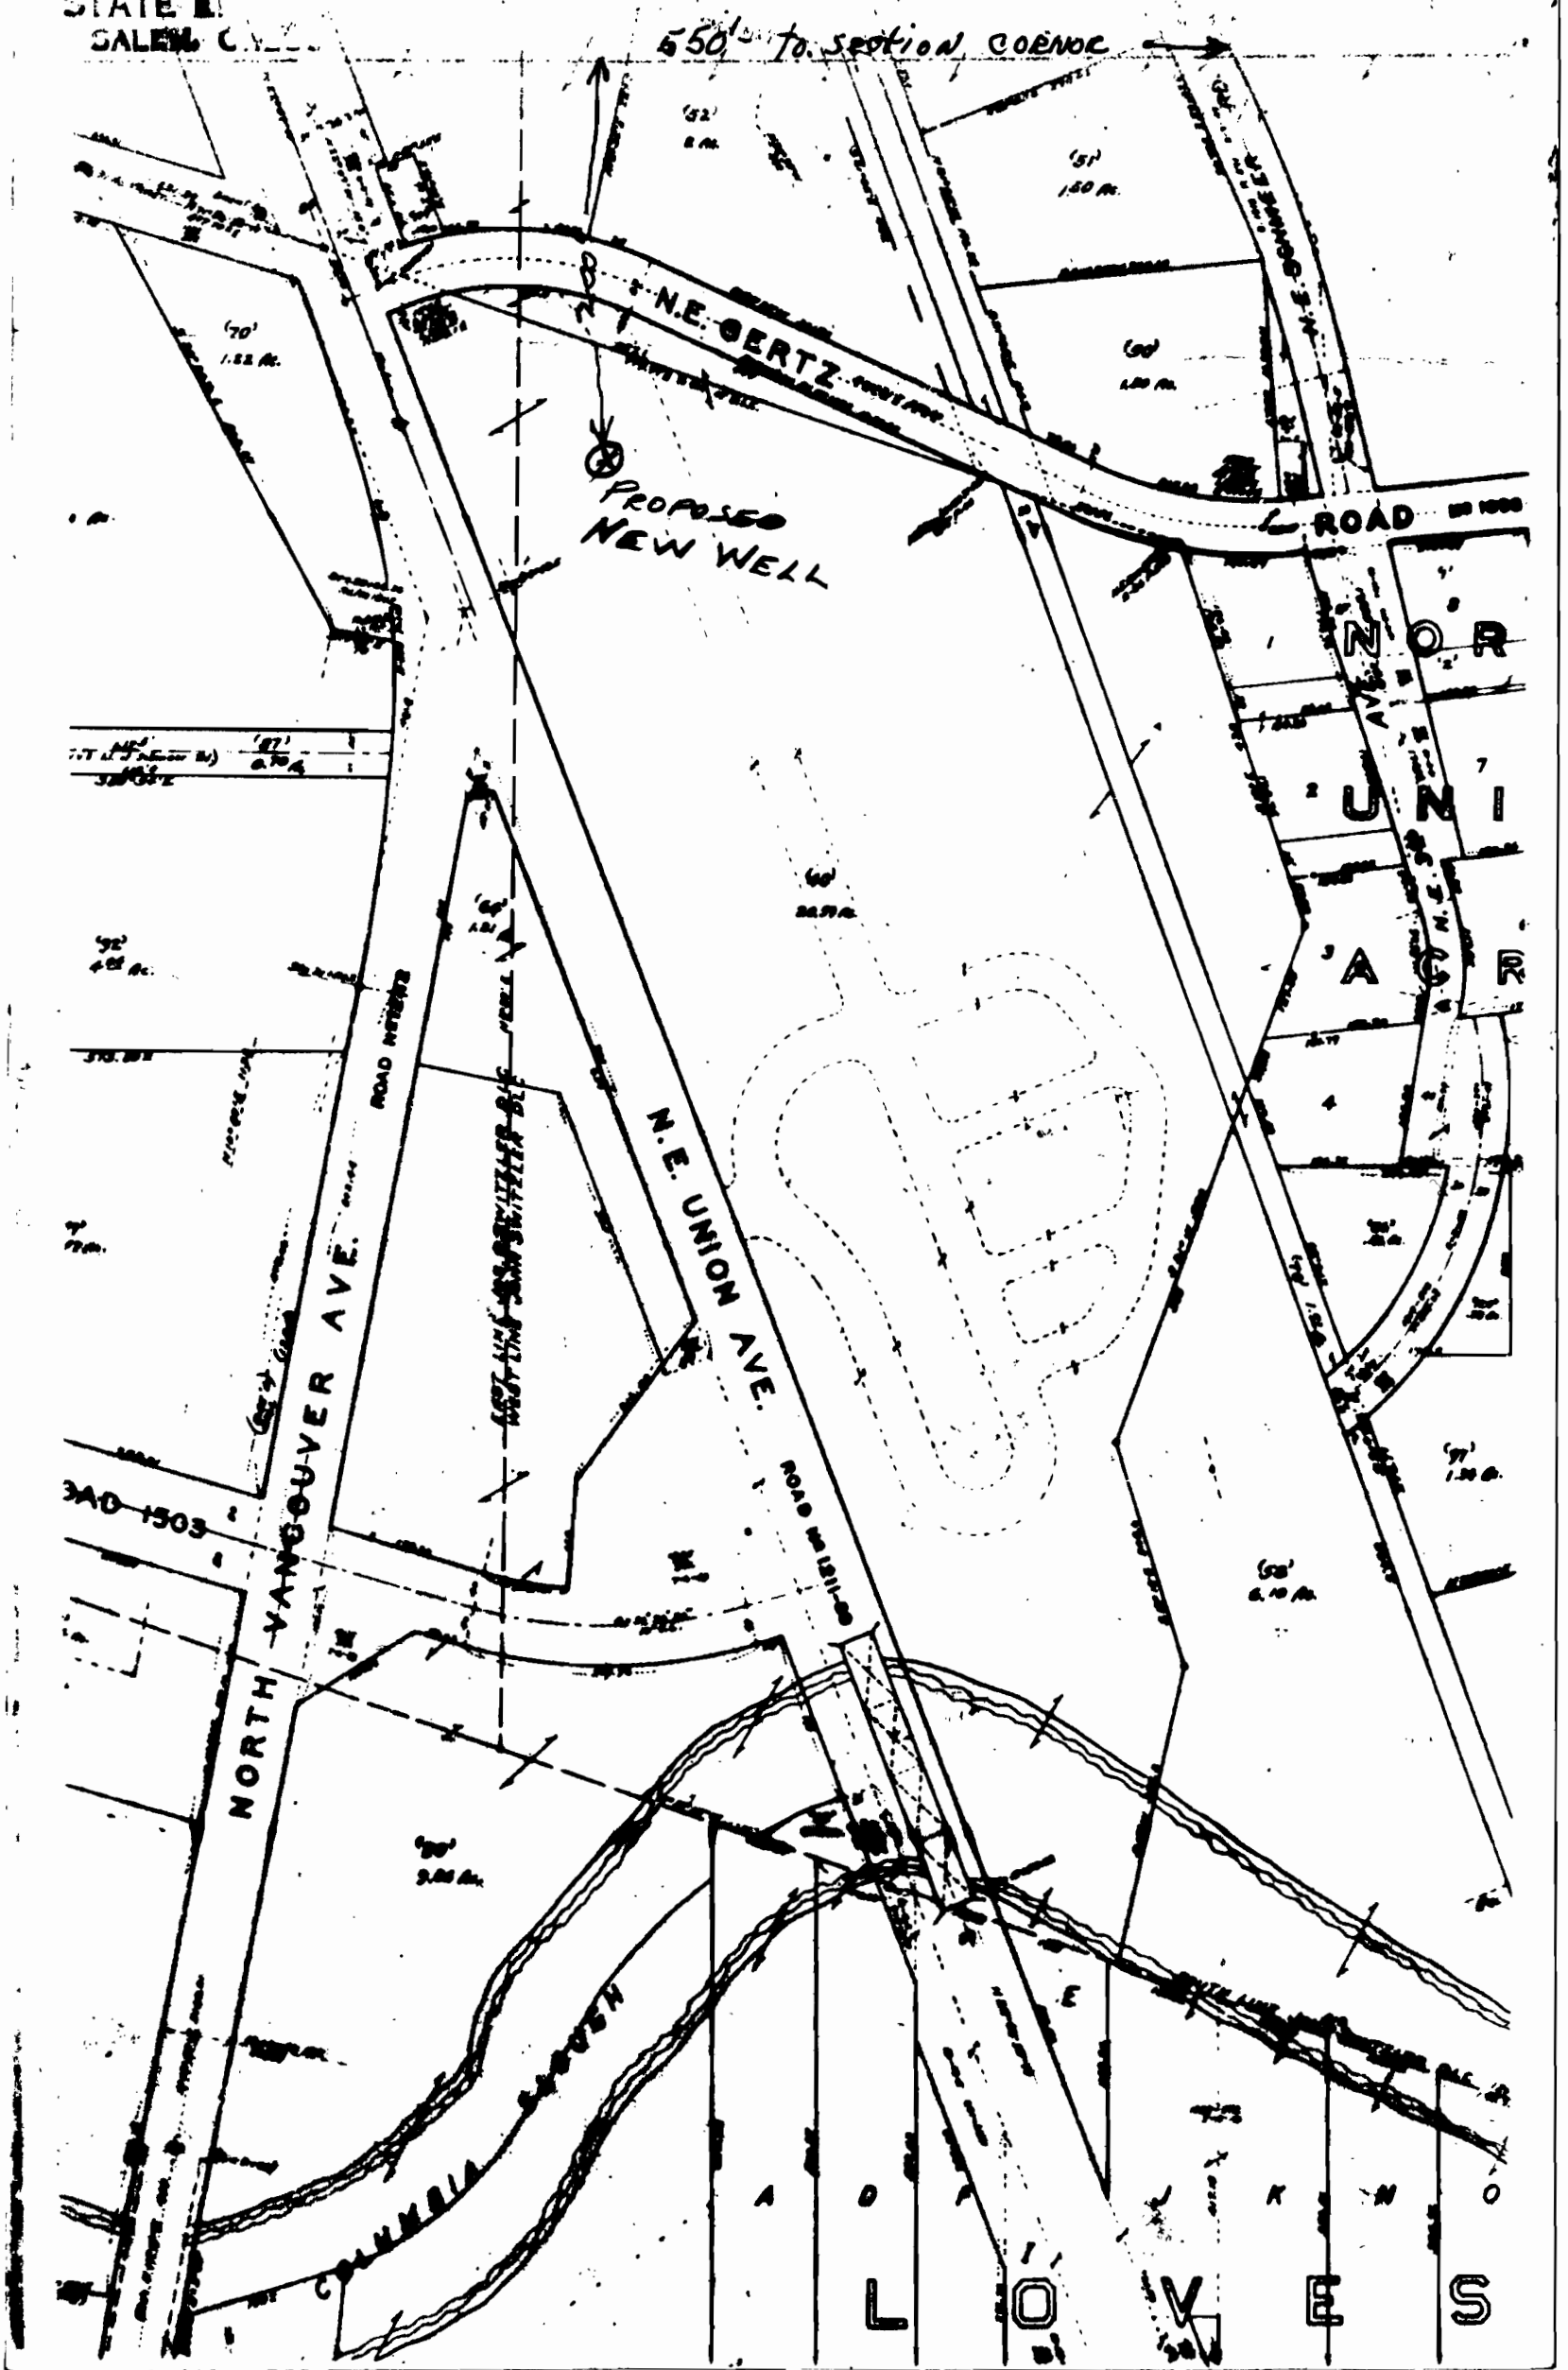

Application No. G-1391
Permit No. G-1270