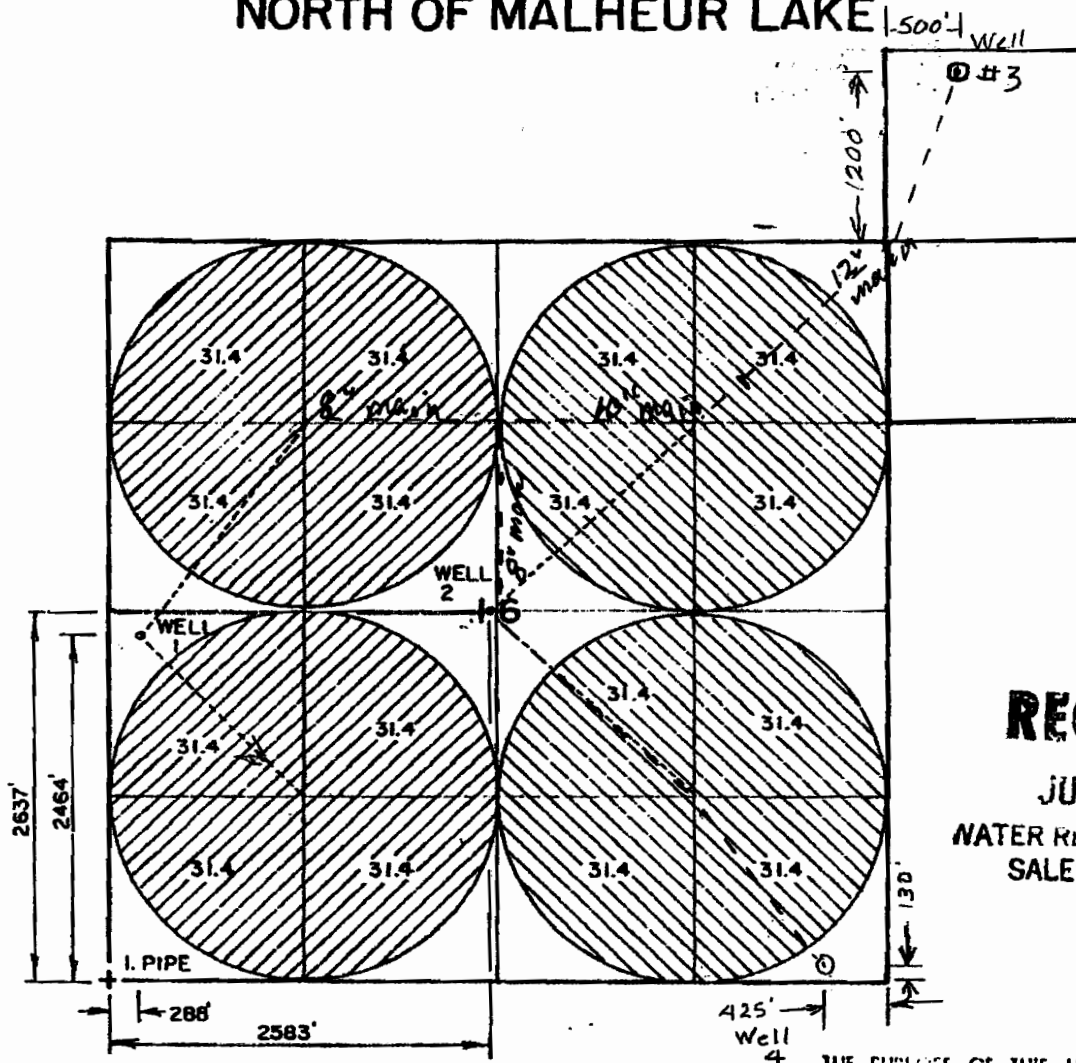


T 26 S, R 30 E, WM

NORTH OF MALHEUR LAKE

**RECEIVED**

JUL 20 1995

WATER RESOURCES DEPT
SALEM, OREGON

Application No. G-14135
Permit No. G12760

THE PURPOSE OF THIS MAP IS TO
 IDENTIFY THE LOCATION OF THE
 WATER RIGHT. IT IS NOT INTENDED
 TO BE USED FOR EASEMENT RELATIVE
 TO THE LOCATION OF PROPERTY
 OWNERSHIP.

CHARLES C. LEATHERS, JR. Assigned To Joseph R. Buerman

WATER RIGHT APPLICATION MAP

Scale: 4" = 1 MILE

Date: APR. 1995

Job: 1569 - A

Dsn:

Dm: CHRIS

Ckd:

MAP's

M. A. PALMER & SONS, INC.
 ENGINEERING & SURVEYING
 254 N. Alder - Box 61
 Burns, Oregon 97720

Sht. No.

of 1

RECEIVED

JAN 13 2006

WATER RESOURCES DEPT
 SALEM, OREGON

10068