



T. 10 S., R. 15 E., W. M.

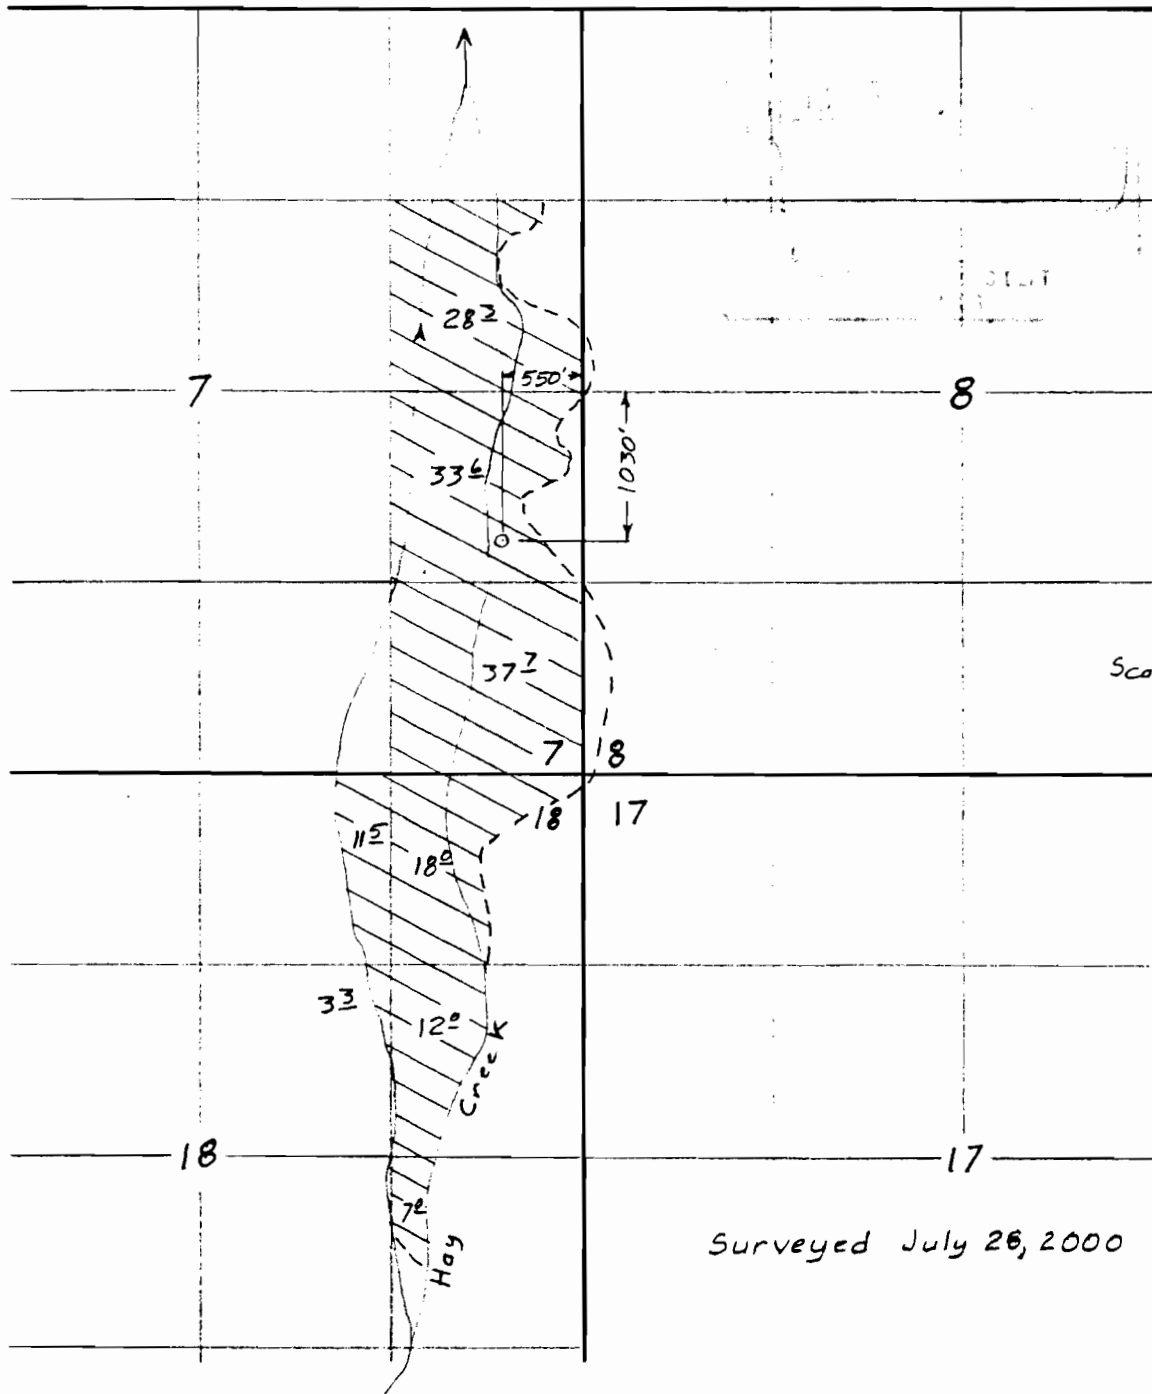

Scale 1" = 1320'

Surveyed July 26, 2000

Claim of Beneficial Use Map
for
HAY CREEK RANCH

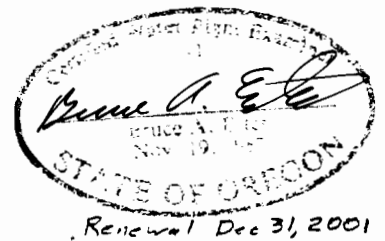

App G-12477
Per G-12762

This map is for the purpose of
locating a water right only
and has no intent to provide
legal dimensions or the location
of property lines.

ESTES SURVEYS

PO Box 17510 60382 Arnold Rd
Salem, OR 97305-7510 Bend, OR 97702
(503) 585-7593 (541) 382-7391