



Supplemental land being irrigated

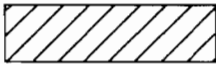

Primary lands being irrigated

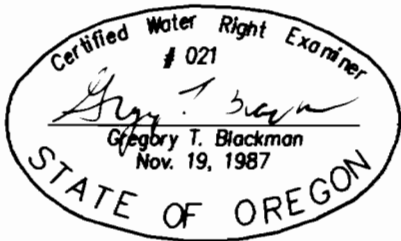

September 10, 2002

**FINAL PROOF MAP OF  
WATER RIGHTS  
FOR  
TOMMY DUNCAN**

BY  
BAGETT - GRIFFITH & BLACKMAN  
2006 ADAMS AVENUE  
LAGRANDE, OREGON 97850

NOTE: The preparation of this map was for the purpose of identifying the location of the proposed water right and has no intent to provide dimensions or location of property ownership lines. Location information shown hereon was furnished by the applicant.

Application No. G-13913  
Permit number G-12771