


**CLAIM OF BENEFICIAL USE MAP**

SCALE: 1 INCH = 400 FEET

PREPARED BY:  
 JONATHAN C. SPERO C.W.R.E. 123  
 1002 KINCAID RD./P.O. BOX 16  
 WILLIAMS, OREGON 97544  
 PH. (541) 846-6845

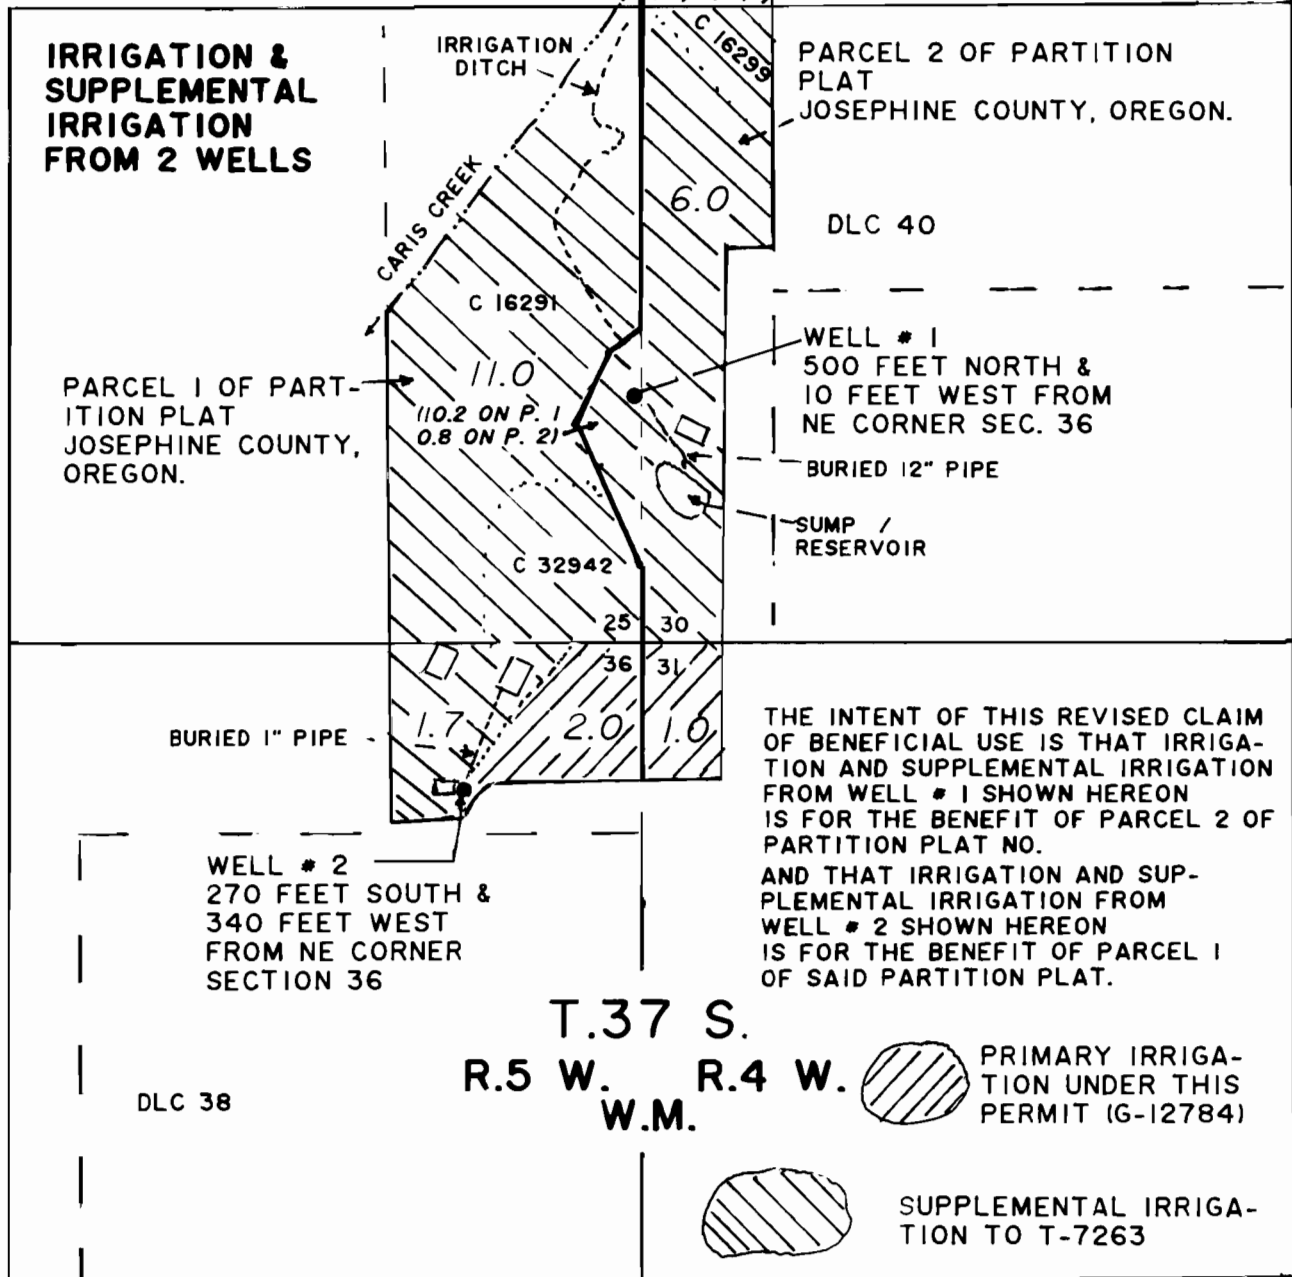

THE INTENT OF THIS REVISED CLAIM OF BENEFICIAL USE IS THAT IRRIGATION AND SUPPLEMENTAL IRRIGATION FROM WELL # 1 SHOWN HEREON IS FOR THE BENEFIT OF PARCEL 2 OF PARTITION PLAT NO. AND THAT IRRIGATION AND SUPPLEMENTAL IRRIGATION FROM WELL # 2 SHOWN HEREON IS FOR THE BENEFIT OF PARCEL 1 OF SAID PARTITION PLAT.

**UNDER:  
 APPLICATION G-13891 PERMIT G-12784  
 IN NAME OF: CHERYL L. SHAW**

SURVEYED JULY 16, 1999  
 THIS REVISED CLAIM MAP  
 PREPARED MARCH 3, 2003

*Jonathan C. Spero*



THIS MAP IS FOR THE PURPOSE OF IDENTIFYING THE LOCATION OF THE WATER RIGHT ONLY, AND IS NOT INTENDED TO PROVIDE LEGAL DIMENSIONS OR LOCATIONS OF PROPERTY OWNERSHIP LINES.

LICENSE RENEWAL DATE:  
 JUNE 30, 2004