

WELLS IN PRODUCTION

WELLS PROPOSED

WELL SITE "A-4"  
 220' North, 520' East  
 from the Southwest corner  
 sec. 17, T.18S, R.12E, W.M.

WELL SITE "A"  
 2400' South, 1800' West  
 from the Northeast corner  
 sec. 13, T.18S, R.11E, W.M.  
 20,000 gal. res.

WELL SITE "B"  
 well no.1:  
 1380' South, 1500' West  
 from the Northeast corner  
 sec. 19, T.18S, R.12E, W.M.  
 100,000 gal. res.

well no. 2  
 1360' South, 1490' West, from  
 the Northeast corner Sec.19  
 T.18S, R.12E W.M. (SW 1/4, SE 1/4)

WELL SITE "C"  
 well no.1:  
 2225' South, 315' West  
 from the Northeast corner  
 sec. 21, T.18S, R.12E, W.M.

well no.2:  
 2260' South, 300' West  
 from the Northeast corner  
 sec. 21 T.18S, R.12E, W.M.

well no.3:  
 2240' South, 310' West  
 from the Northeast corner  
 sec. 21 T.18S, R.12E, W.M.  
 3,000,000 gal. res.  
 located on China Hat Road

WELL SITE "E"  
 well no. 1  
 1019' North, 640' West  
 from the Southeast corner  
 sec. 18, T.18S, R.12E, W.M.

well no. 2  
 1030' North, 640' West from  
 the SE corner of sec. 18,  
 R.12E, W.M (SE 1/4, SE 1/4)



WELLS IN RESERVE

WELL SITE "D"  
 well no.1: reserve  
 1550' South, 1700' East  
 from the Northwest corner  
 sec. 8, T.17S, R.12E, W.M.

well no.2: reserve  
 1600' South, 1680' East  
 from the Northwest corner  
 sec. 8 T.17S, R.12E, W.M.

well no.3: reserve  
 1700' South, 1780' East  
 from the Northwest corner  
 sec. 8 T.17S, R.12E, W.M.  
 30,000 gal. res.

WELL SITE "F"  
 well no. 1:  
 75' North, 100' West  
 from the Southeast corner  
 sec. 6, T.18S, R.12E, W.M.

well no. 2:  
 90' North, 95' West  
 from the Southeast corner  
 sec.6, T.18S, R.12E, W. M.

WELL SITE "G"  
 well no. 1:  
 264' North, 947' West  
 from the Southeast corner  
 sec. 3, T.18S, R.12E, W.M.

well no. 2:  
 274' North, 937' West  
 from the Southeast corner  
 sec.3, T.18S, R.12E, W. M.

WELL SITE "H"  
 well no. 1:  
 400' South, 200' West  
 from the North quarter  
 corner sec. 3, T.18S,  
 R.12E, W.M.

well no. 2:  
 400' South, 86' West  
 from the North quarter  
 corner sec.3, T.18S,  
 R.12E, W. M.

WELL SITE "I"  
 868' South, 116' East  
 from the Center quarter  
 corner sec. 26, T.17S,  
 R.12E, W.M.

WELL SITE "J"  
 343' North, 892' East  
 from the Southwest corner  
 sec. 14, T.17S, R.12E, W.M.


WELL SITE "K"  
 1973' South, 575' West  
 from the Center quarter  
 corner sec. 16, T.17S,  
 R.12E, W.M.

WELL SITE "L"  
 1425' South, 1950' West  
 from the Northeast corner  
 sec. 16, T.17S, R.12E, W.M.

WELL SITE "M"  
 312' North, 12' West  
 from the Southeast corner  
 sec. 9, T.17S, R.12E, W.M.



OVERLAY MAP BY  
 DESCHUTES DRAFTING  
 AND DESIGN  
 FROM INFORMATION SUPPLIED BY  
 AVION WATER CO., INC  
 QUASI-MUNICIPAL  
 WATER SYSTEM

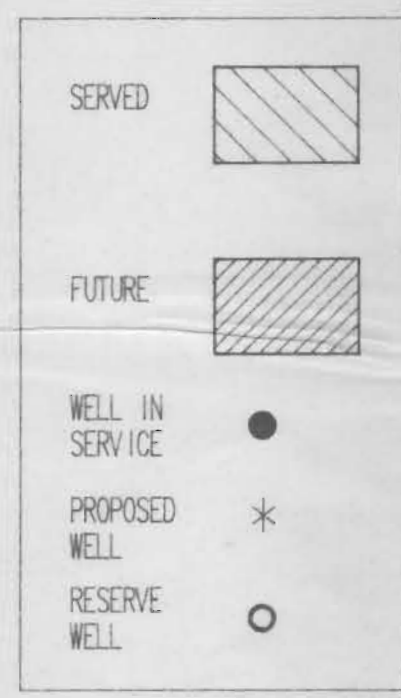

Field review of well  
 sites completed:

Application No. G12924  
 Permit No. G12788

**RECEIVED**  
 JUN 13 1996  
 WATER RESOURCES DEPT.  
 SALEM, OREGON

LAVA BUTTE  
 1771 N NE

BEND, OREGON  
 44-12-A3-TF-024