

CLAIM OF BENEFICIAL USE SURVEY

Located in Section 17, Township 18 South,
Range 12 East, Willamette Meridian,
Deschutes County, Oregon

Bend Golf & Country Club
Tax Lot 2400


Application No. G-12802
Permit No. G-12789



 = Supplemental Water Rights

I, James R. Tye, Certified Water Right Examiner in the
State of Oregon, hereby certify that this water rights
survey map was prepared under my direct supervision.

The preparation of this map is for the purpose of
identifying the location of the water right only and
has no intent to provide dimensions or locations of
property ownership lines.

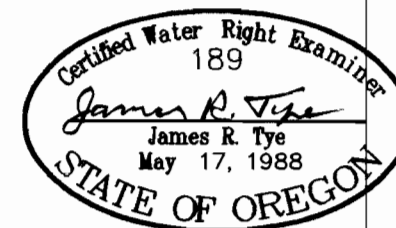

W.O.No.: 5213-22
Date: 9-26-00
Scale: 1"=400'

