


SECTION 34 T.39S. R.12E. W.M.  
KLAMATH COUNTY


39 12 34

THIS MAP WAS PREPARED FOR  
ASSESSMENT PURPOSE ONLY.

1"=400'

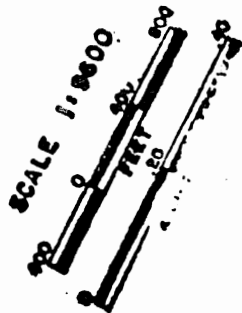

Application No. 6-13748  
Parcel No.

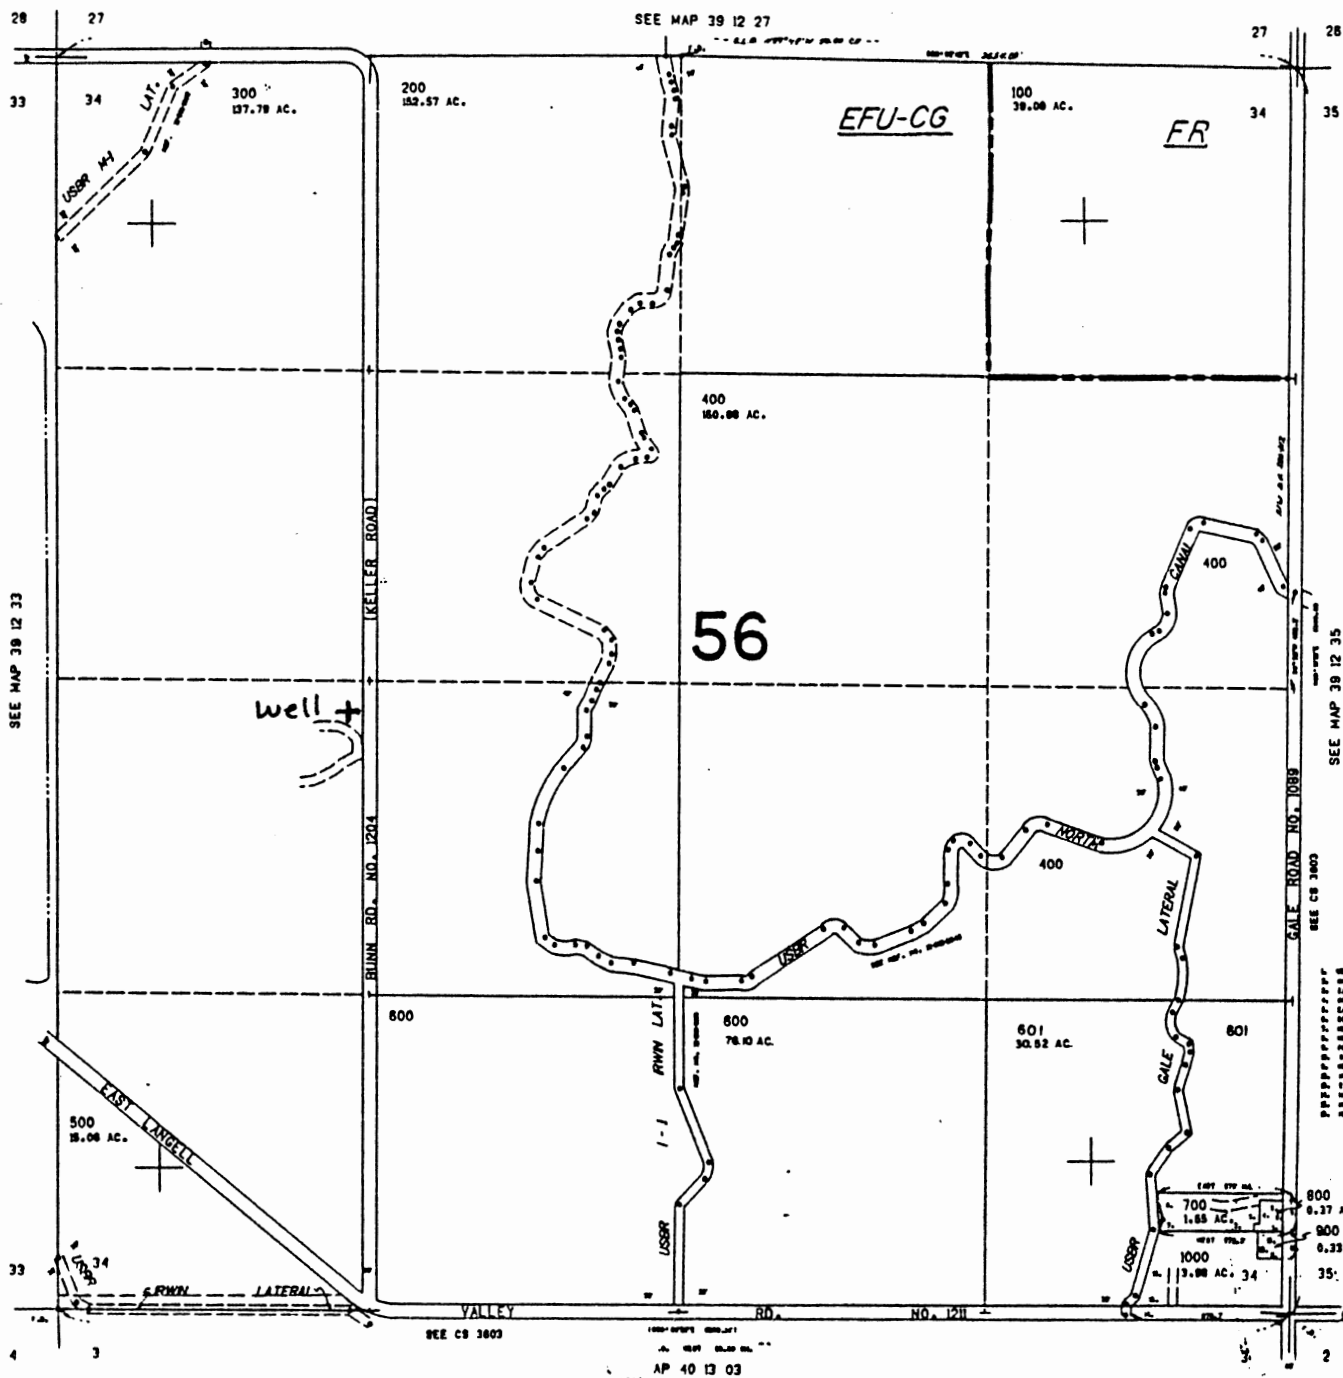

39 12 34