
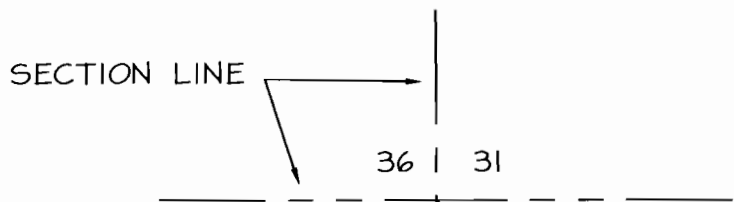




SECTION 1, TOWNSHIP 18 SOUTH, RANGE 3 WEST, W.M.  
AND  
SECTION 6, TOWNSHIP 18 SOUTH, RANGE 2 WEST, W.M.

RECEIVED

FEB 10 1998

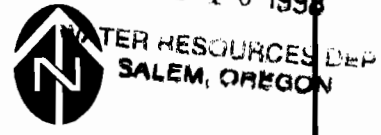

SCALE: 1"=400'

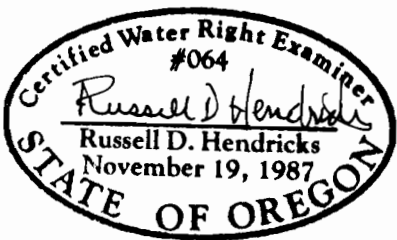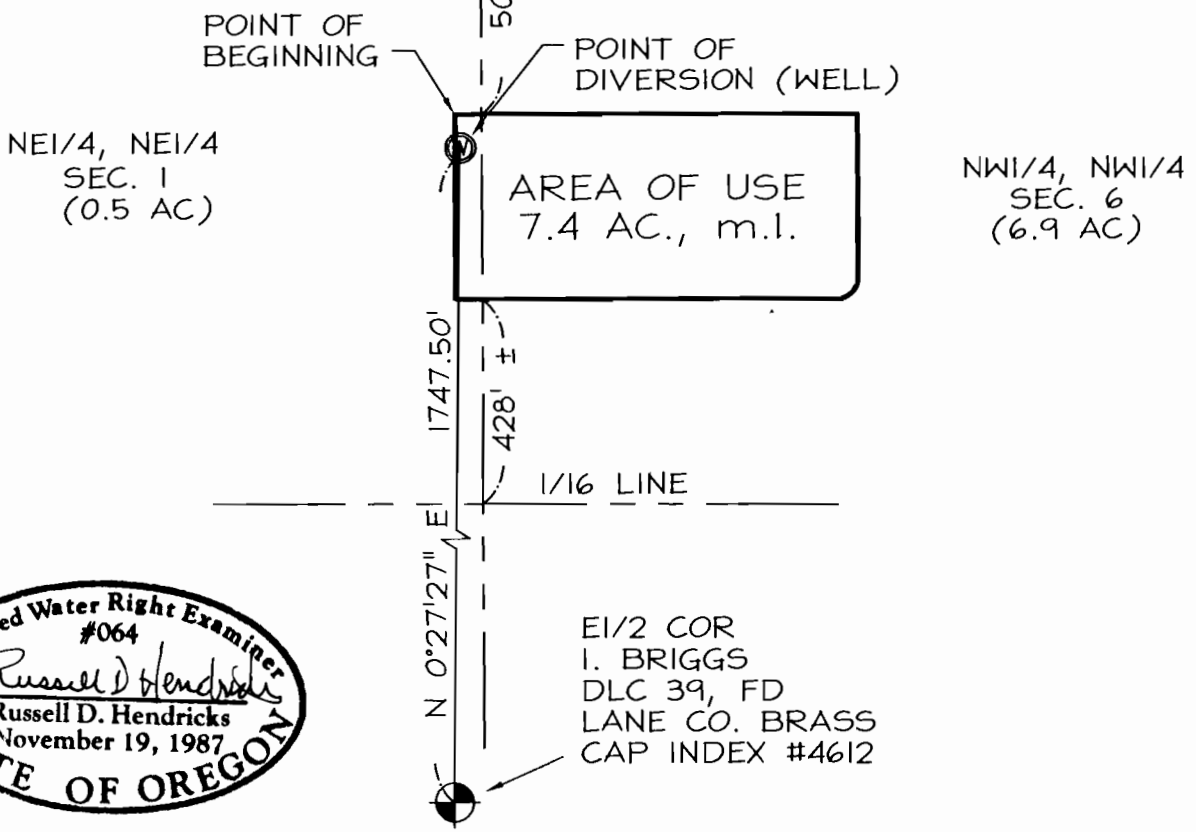

FINAL PROOF SURVEY  
UNDER  
APPL. No. G-13948, PER No. G-12792  
JANUARY 26, 1998

THIS MAP IS FOR THE PURPOSE OF IDENTIFYING THE WATER RIGHT ONLY AND IS NOT TO PROVIDE LEGAL DIMENSIONS OR LOCATIONS OF PROPERTY OWNERSHIP LINES.