



T. 10 & 11 S., R. 15 E., W. M.

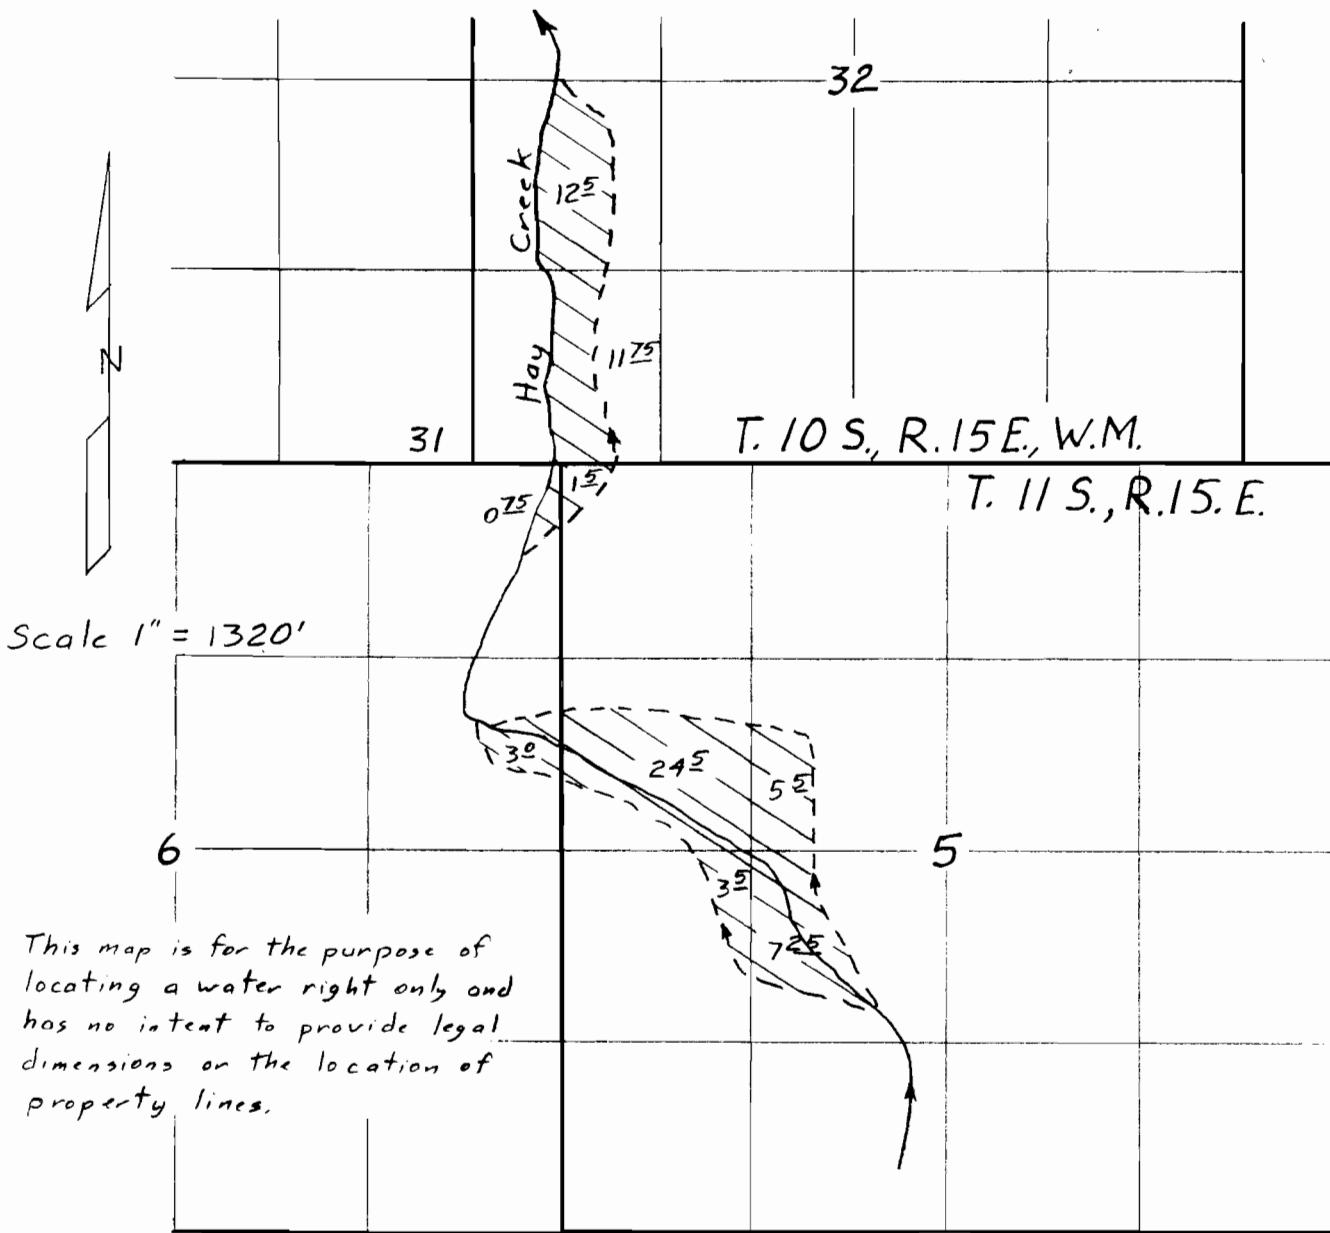

Supp. Irr.

Application Map For  
**HAY CREEK RANCH**  
 Niki Clark, Owner

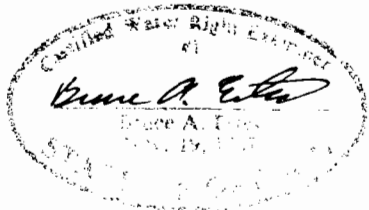

Sheet 1 of 3

Application G-12478  
 Permit G12807


TOWNSHIP 11 SOUTH, RANGE 15 EAST, W. M.

Superseding

RECEIVED

MAR 9 1994

WATER RESOURCES DEPT  
SALEM, OREGON

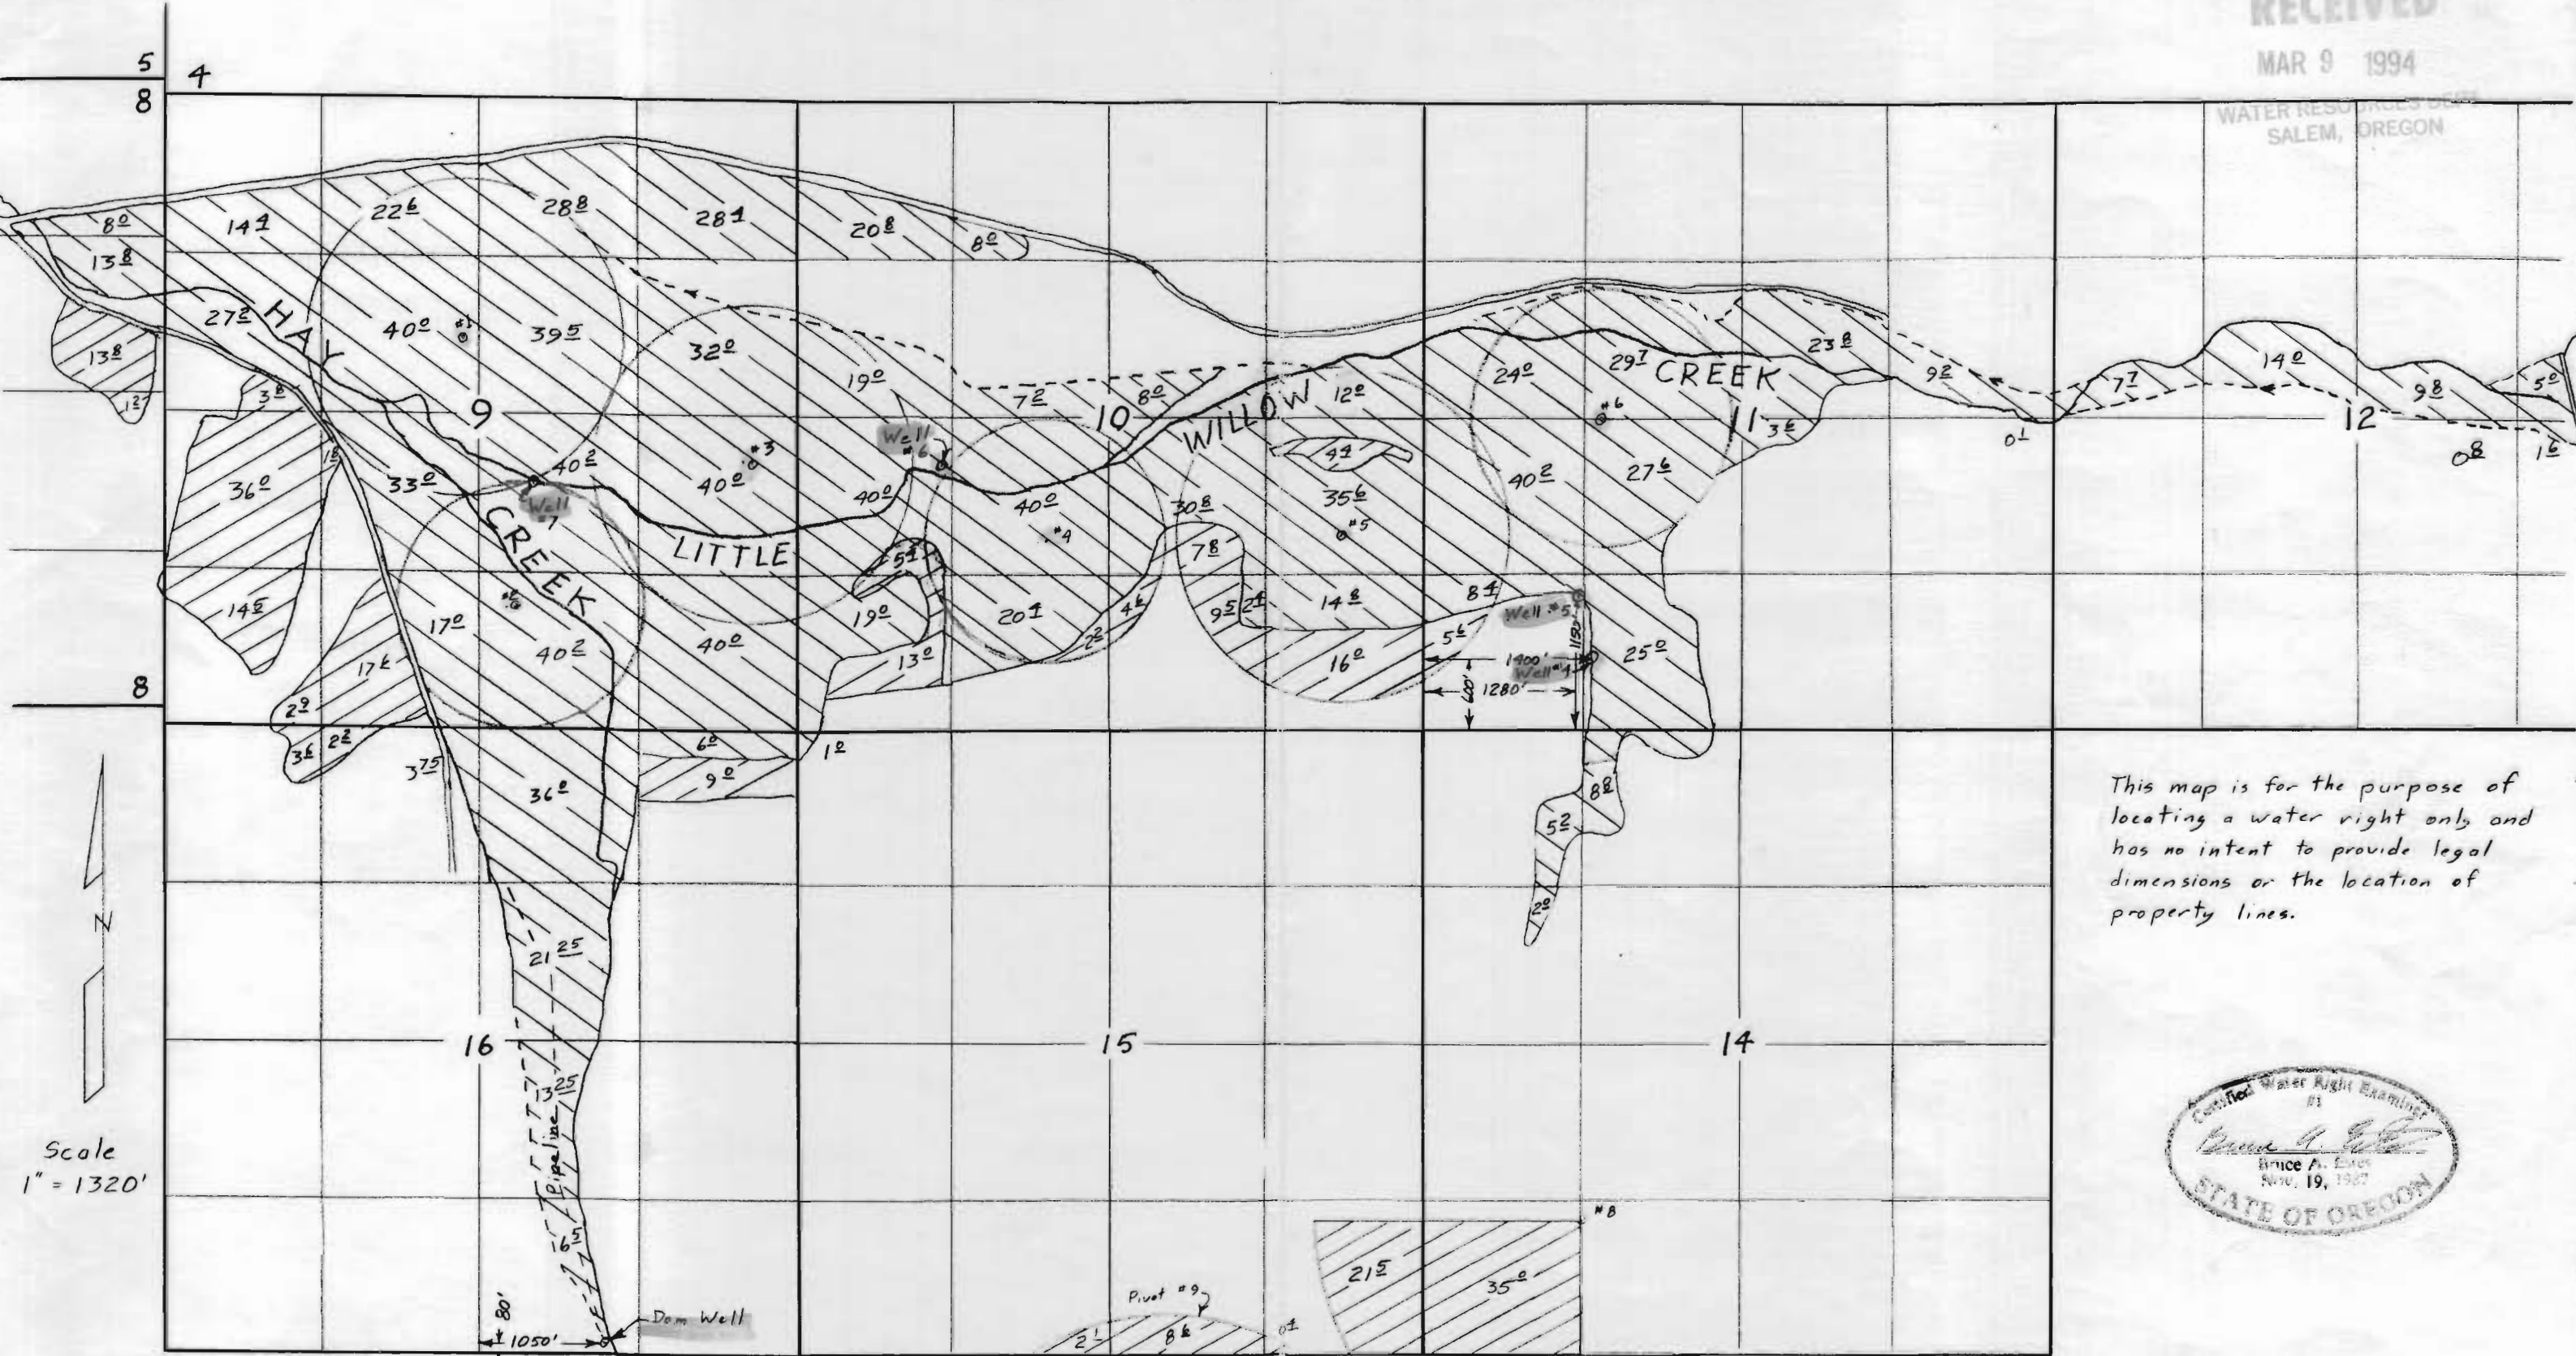

This map is for the purpose of locating a water right only, and has no intent to provide legal dimensions or the location of property lines.



Scale  
1" = 1320'

- Primary Irrigation
- Supplemental Irrigation


Application Map For  
HAY CREEK RANCH  
Niki Clark, Owner

Application G-12478  
Permit G12807

TOWNSHIP 11 SOUTH, RANGE 15 EAST, W. M.

Superseding

RECEIVED  
MAR 8 1994  
WATER RESOURCES DEPT.  
SALEM, OREGON


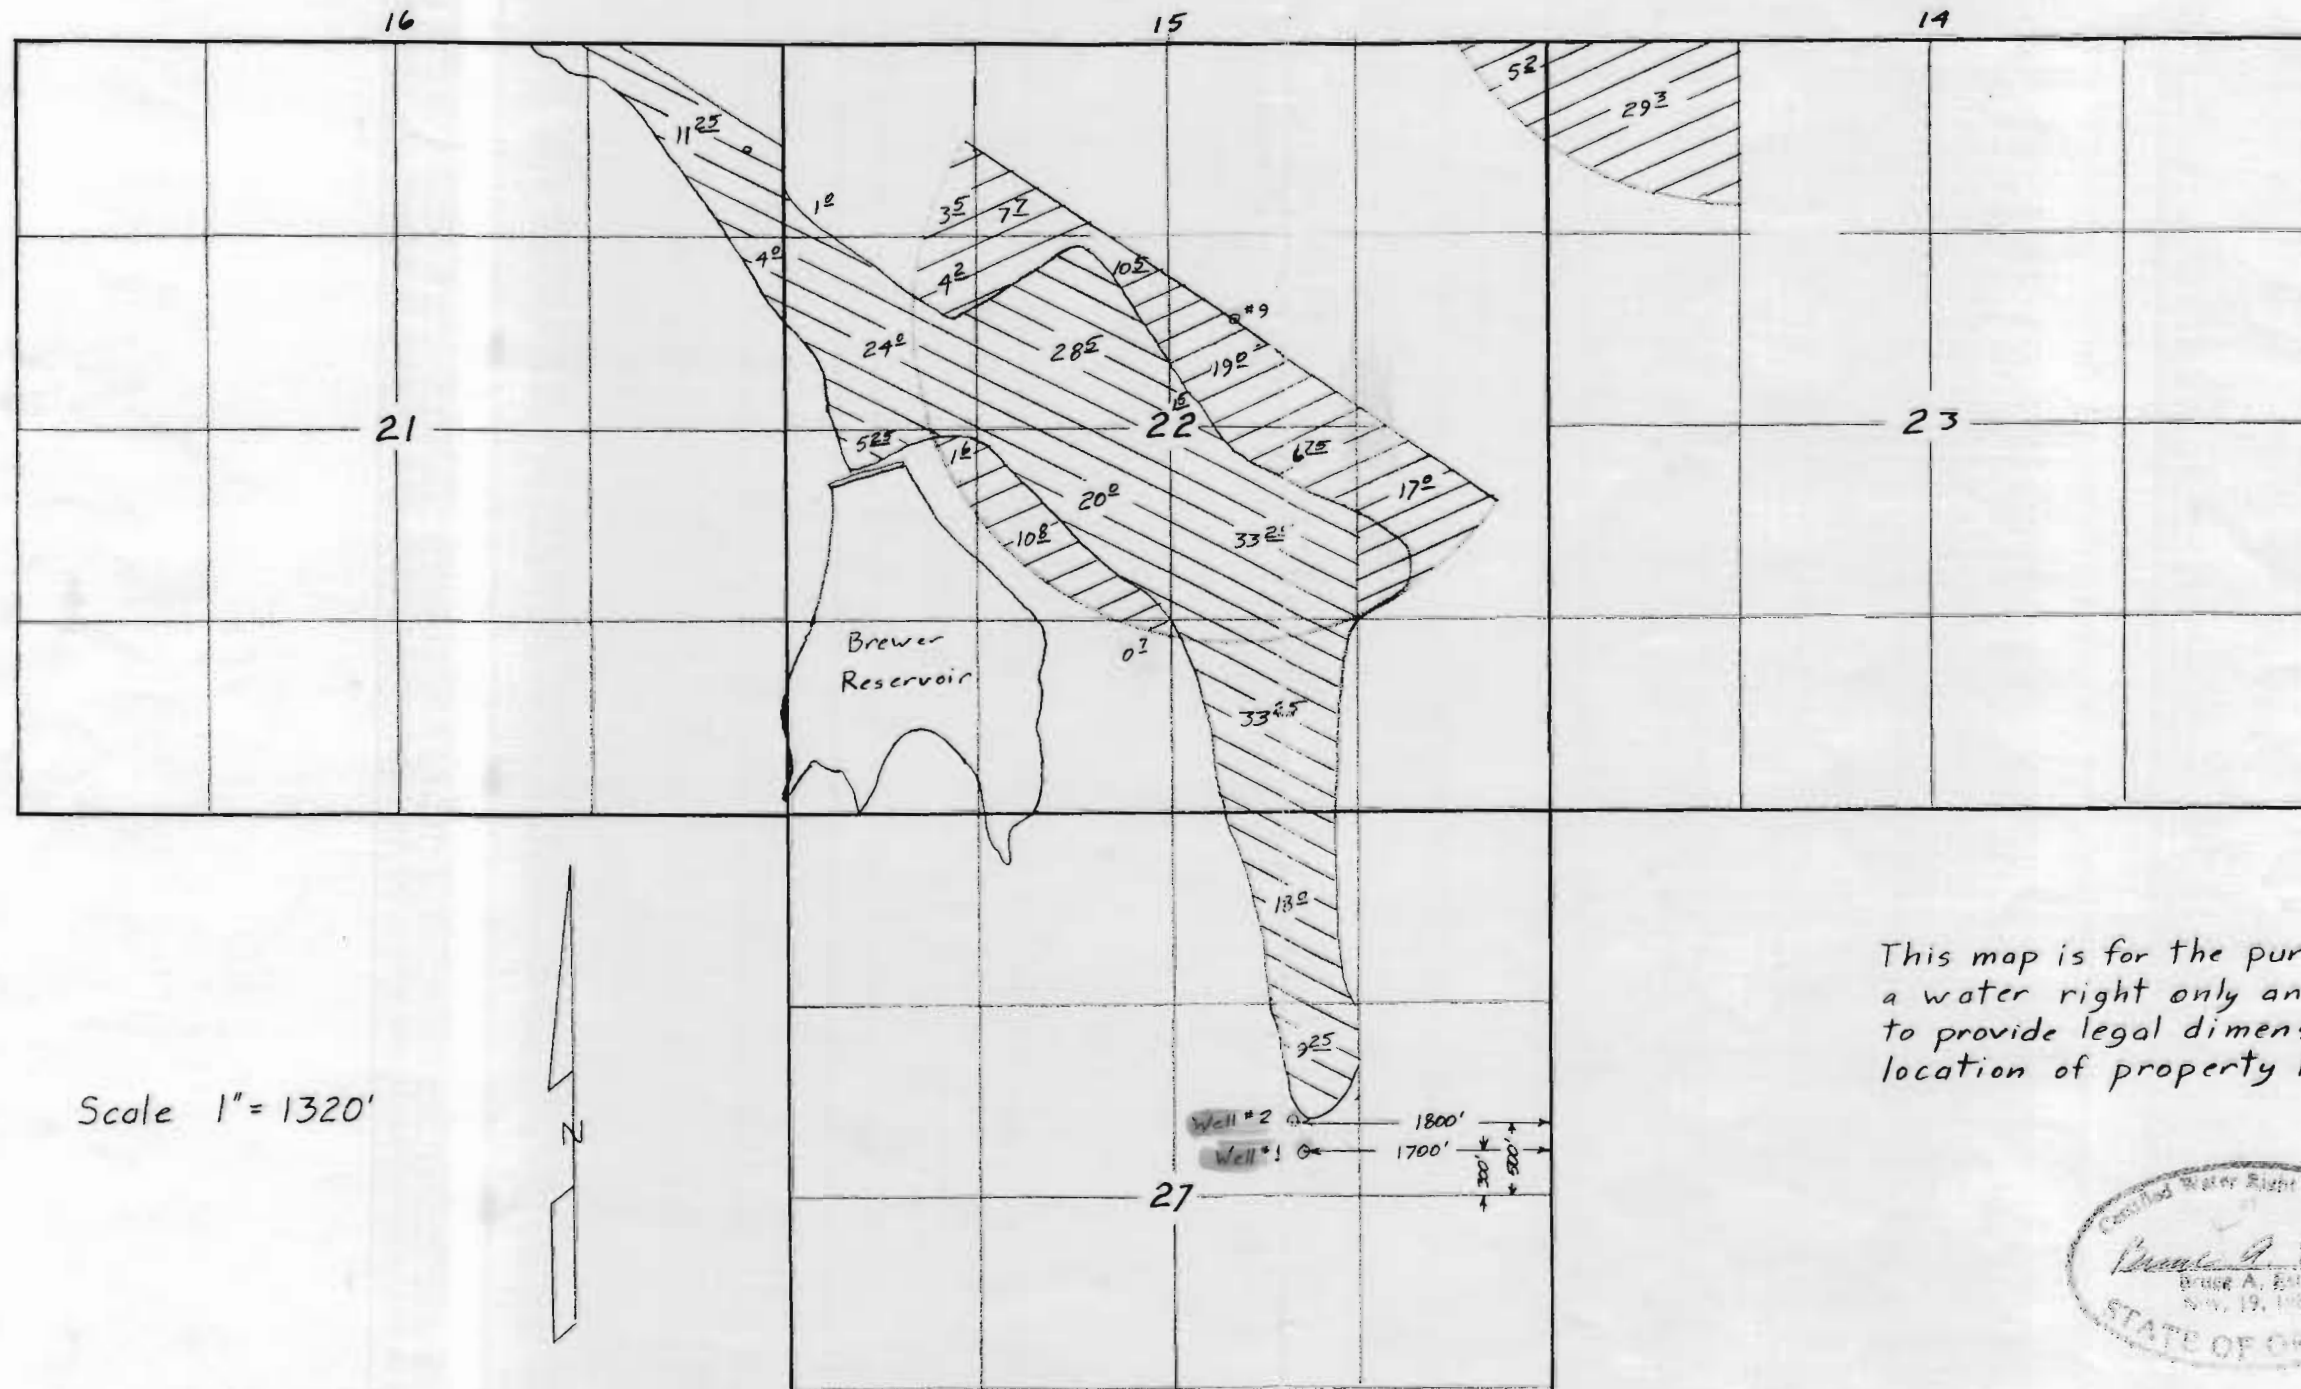


Scale 1" = 1320'



This map is for the purpose of locating a water right only and has no intent to provide legal dimensions or the location of property lines.

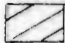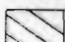

-  Primary Irrigation
-  Supplemental Irrigation

Application Map For  
HAY CREEK RANCH  
Niki Clark, Owner

Application G-12478  
Permit G12807

Sheet 3 of 3

Revised 9 Mar 94