

Township 39 South of Range 3 West  
 Willamette Base & Meridian  
 Jackson County, Oregon

Section 28  
 SW 1/4 of SW 1/4

Section 28  
 SE 1/4 of SW 1/4


**Claim of Beneficial Use**

in the name of  
 Frank E. and Julie E. Rodreick

Permit No. G12809  
 Application file No. G13911


SE 1/4 of SW 1/4 Section 28 0.09 acres  
 SW 1/4 of SW 1/4 Section 28 0.46 acres  
 NW 1/4 of NW 1/4 Section 33 6.60 acres  
 NE 1/4 of NW 1/4 Section 33 0.81 acres

total acreage 7.96 acres

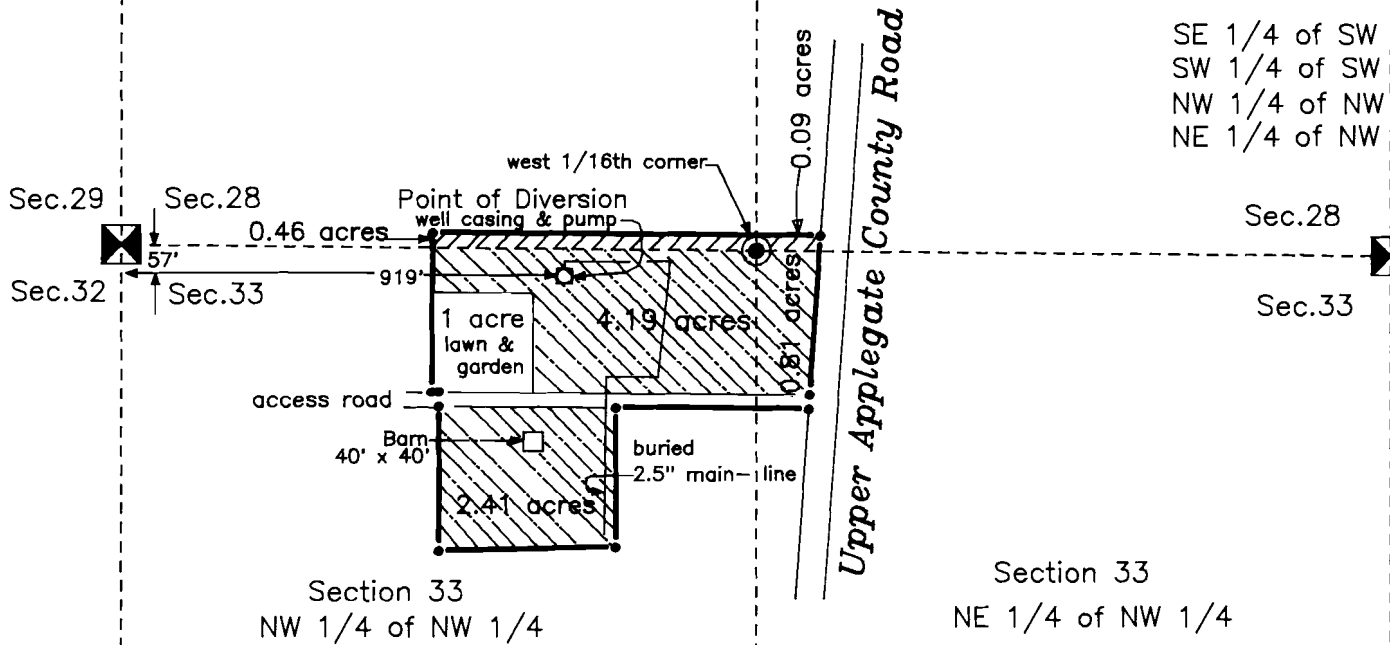

Sec.28 One/Quarter Corner

Sec.33

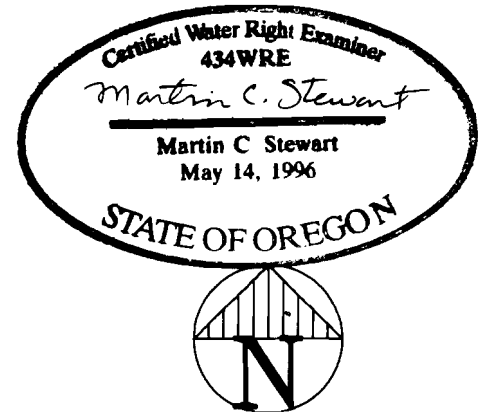

Section 33  
 NE 1/4 of NW 1/4

This map is for the purpose of locating a water right, only. There is no intent hereon to provide property descriptions, dimensions or locations.

