

# CLAIM OF BENEFICIAL USE

APPLICATION No. G-13970

PERMIT No. G-12820



Sections 29 & 30, T20S, R46E, WM

TAX LOT No. 20-46-D-5100, 5300 & 5800 - MALHEUR COUNTY



FOR: Charles Okano  
2580 Norwood Avenue  
Nyssa, OR 97913

SCALE: 1" = 1320'

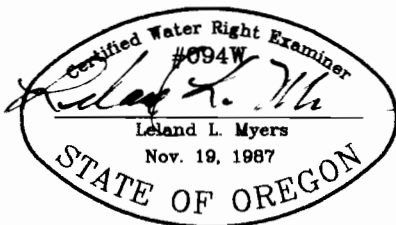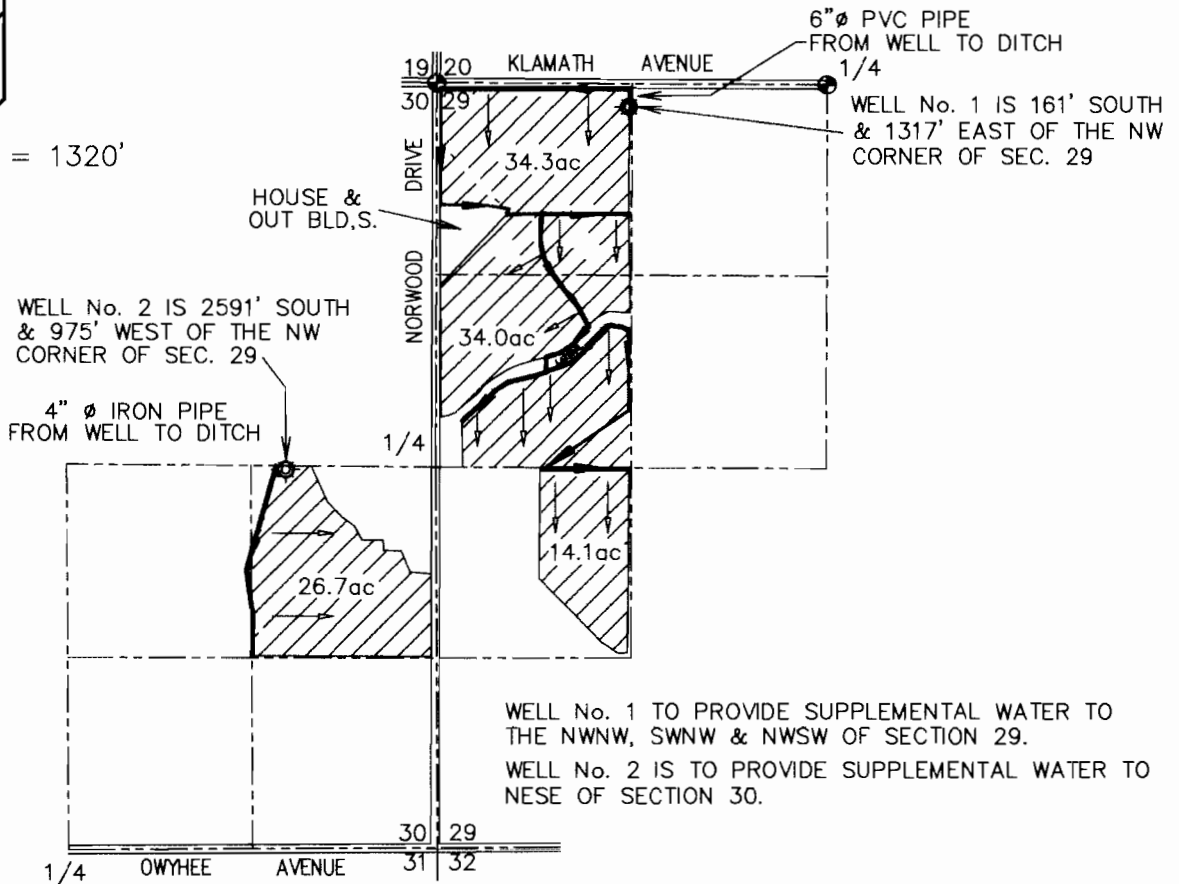

This map is for the purpose of identifying the location of the water right only and has no intent to provide dimensions or location of property ownership lines.

RECEIVED