

# Claim of Beneficial Use

APPLICATION No. G-14051      PERMIT No. G-12823

Section 20, T17S, R44E, WM - TAX LOT No. 17 44C 300 - MALHEUR COUNTY

FOR: Wayne McConnell  
4450 S Road G  
Vale, OR 97918



## LEGEND


SUPPLEMENTAL RIGHT



PRIMARY RIGHT



SCALE: 1" = 400'

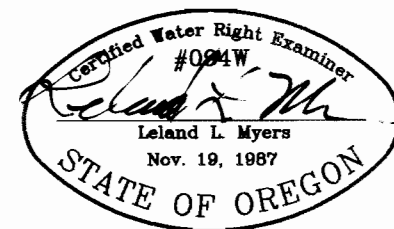

This map is for the purpose of identifying the location of the water right only and has no intent to provide dimensions or location of property ownership lines.