


T. 8S., R. 46E., W.M.

OFFICE OF THE
WATER RESOURCES DIVISION
DEPARTMENT OF AGRICULTURE
STATE OF OREGON

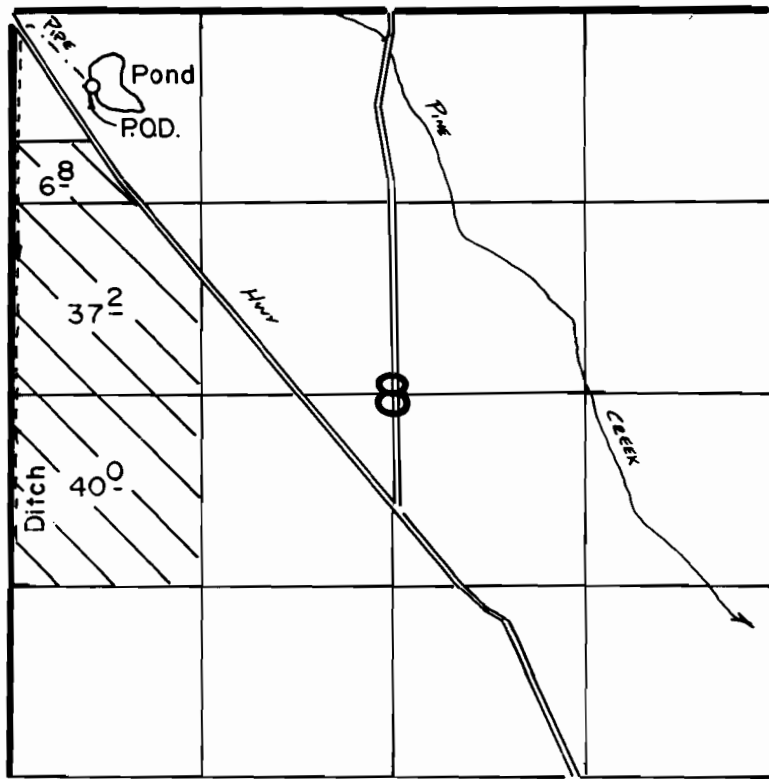

SCALE 1" = 1320'



P.O.D. Located 530'S. & 590'E From NW cor Sec 8

The purpose of this map is for identifying the location of the water right only and is not intended to provide legal dimensions of property ownership lines.

FINAL PROOF SURVEY

APPL. G-14153

PER. G-12826

IN NAME OF

GORDON W. SUMMERS

Surveyed Apr. 1, 1998

