


T1S R3W W.M.

SEP 30 1998

WATER RESOURCES DEPT
SELEM, OREGON

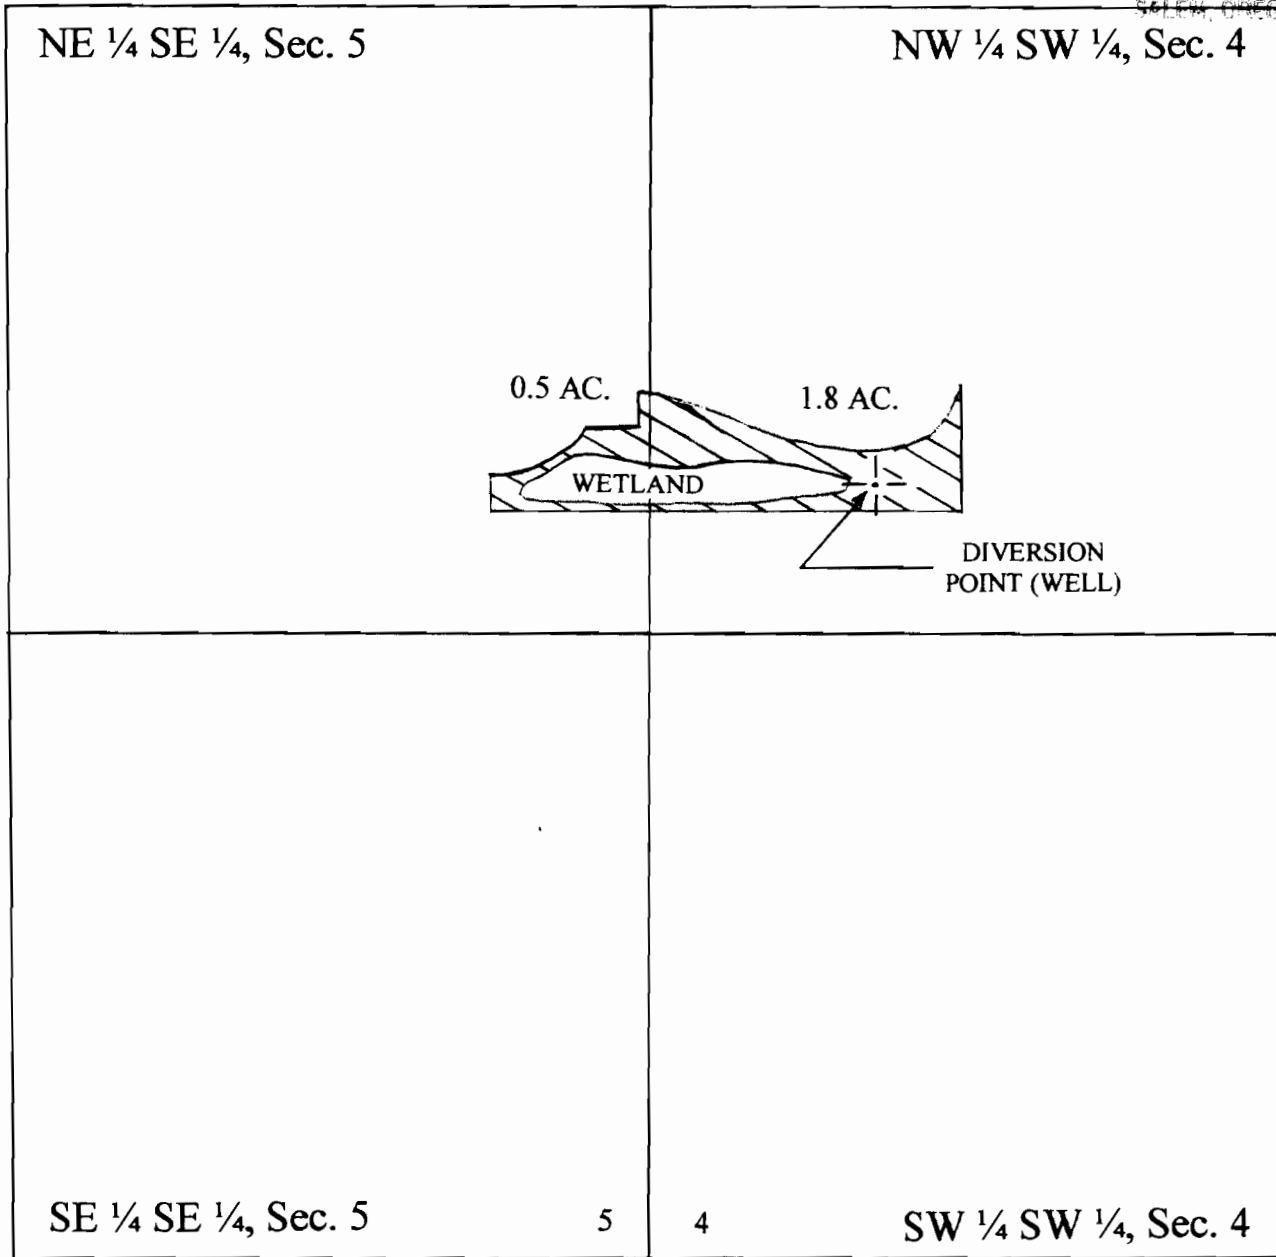

Scale: 1" = 400'

DIVERSION POINT IS LOCATED 1610' N. & 470' E.
FROM THE SW CORNER OF SECTION 4

FINAL PROOF SURVEY

Application G-14170

Permit G-12843

September 24, 1998

THIS MAP WAS PREPARED FOR THE PURPOSE OF IDENTIFYING THE LOCATION OF WATER RIGHTS ONLY AND IS NOT INTENDED TO PROVIDE LEGAL DIMENSIONS OR LOCATION OF PROPERTY OWNERSHIP LINES.

Benjamin L. Colige