


Post-it* Fax Note 7871 Date 4-10-06 Page 2
 To Carrie Jones From Gony Clark
 Co. Dept. Baker with office
 Phone # 503-986-0811
 Fax #

64552

CLAIM OF BENEFICIAL USE MAP

Application Nos. G-10846, G-14081, 6452 & 54701 -- Permit Nos. G-10005, G-12850, 47290 & 41864
 Section 13, T9S, R39E, WM -- Western Heights Subdivision -- Baker County, Oregon
 Powder River Basin

Tax Lot Nos. 9-39-13A, 1800 thru 3800; 9-39-13B, 20C thru 2200; 9-39-13C, 200; and 9-39-13D, 100 Thru 600

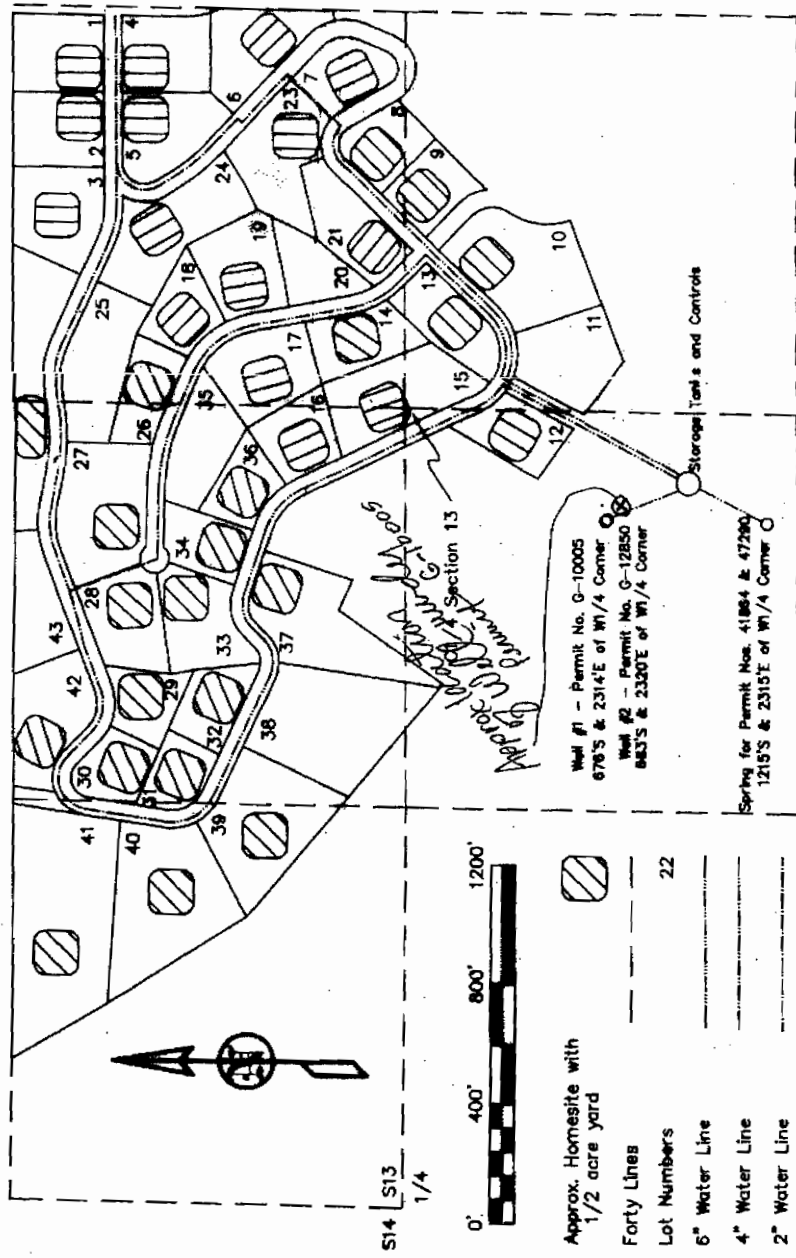

Permit No. 41864 with Permit No. G-10005 and Supplement Permit No. G-12850
 Permit No. 47290 with Permit No. G-10005 and Supplement Permit No. G-12850

This map is for the purpose of identifying the location of the water right only and has no intent to provide dimensions or location of property ownership lines.



COBU MAP # 0154